

STATE ENGINEER
Salem, Oregon

Well Record

STATE WELL NO. 15/4W-30M
COUNTY LANE
APPLICATION NO. GR-2431

OWNER: D. S. McGahey

MAILING
ADDRESS:

Star Route M

LOCATION OF WELL: Owner's No. #1


CITY AND
STATE:

Junction City, Oregon

NW $\frac{1}{4}$ SW $\frac{1}{4}$ Sec. 30 T. 15 N. S. R. 4 E. W. W.M.

Bearing and distance from section or subdivision

corner S. 47° E. 930'

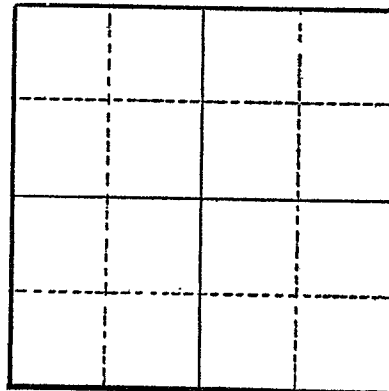

Section

Altitude at well

TYPE OF WELL: Driven Date Constructed 1953

Depth drilled 20 Depth cased 20

CASING RECORD:

4-inch

FINISH:

6 3/8" x 3" from 17 to 20

AQUIFERS:

Topsoil, clay and gravel

WATER LEVEL:

8-feet

PUMPING EQUIPMENT: Type Centrifugal
Capacity 140 G.P.M.

H.P. 5

WELL TESTS:

Drawdown 6 ft. after hours Pumping 120 G.P.M.

Drawdown ft. after hours G.P.M.

USE OF WATER Irrigation Temp. °F. , 19.

SOURCE OF INFORMATION GR-2306

DRILLER or DIGGER

ADDITIONAL DATA:

Log X Water Level Measurements Chemical Analysis Aquifer Test

REMARKS:

Amity topsoil, clay 8 8
Gravel, water bearing 12 21