

STATE ENGINEER  
Salem, Oregon

LANE  
4299

# Well Record


STATE WELL NO. 15/4W - 300  
COUNTY LANE  
APPLICATION NO. GR-2155

OWNER: H. O. Paeschke MAILING ADDRESS: Junction City,

LOCATION OF WELL: Owner's No. #1 CITY AND STATE: Oregon

SW 1/4 SE 1/4 Sec. 30 T. 15 N. S., R. 4 E. W., W.M.

Bearing and distance from section or subdivision corner 475' N. and 2125' W.

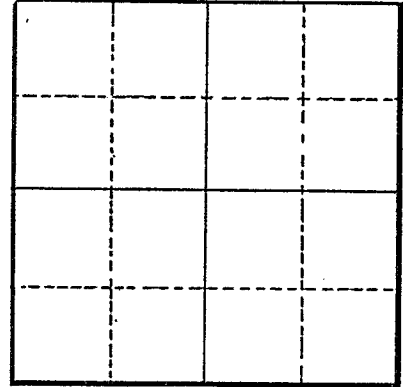

Section \_\_\_\_\_

Altitude at well \_\_\_\_\_

TYPE OF WELL: Driven Date Constructed 1950

Depth drilled 24 Depth cased 24

CASING RECORD:

4-Inches

FINISH:

Perforations from 20 to 24

AQUIFERS:

Loam, soil, sand and gravel

WATER LEVEL:

10-Feet

PUMPING EQUIPMENT: Type Berkeley Centrifugal H.P. 15  
Capacity 400 G.P.M.

WELL TESTS:

Drawdown 2 ft. after \_\_\_\_\_ hours Pumping 400 G.P.M.

Drawdown \_\_\_\_\_ ft. after \_\_\_\_\_ hours \_\_\_\_\_ G.P.M.

USE OF WATER Irrigation Temp. \_\_\_\_\_ °F. \_\_\_\_\_, 19

SOURCE OF INFORMATION GR-2065

DRILLER or DIGGER \_\_\_\_\_

ADDITIONAL DATA:

Log X Water Level Measurements \_\_\_\_\_ Chemical Analysis \_\_\_\_\_ Aquifer Test \_\_\_\_\_

REMARKS:

Loam top soil 12 12  
Sand and gravel 12 0