

STATE ENGINEER
Salem, Oregon

LANE
6360

Well Record

STATE WELL NO. 15/4W - 30R
COUNTY LANE
APPLICATION NO. GR-2157

OWNER: H. O. Panschke MAILING ADDRESS: Junction City,

LOCATION OF WELL: Owner's No. #2 CITY AND STATE: Oregon


SE 1/4 SE 1/4 Sec. 30 T. 15 S., R. 4 W., W.M.

Bearing and distance from section or subdivision corner 650' N. and 1070' W.

Altitude at well _____

TYPE OF WELL: Driven Date Constructed 1950

Depth drilled 20 Depth cased 20 14

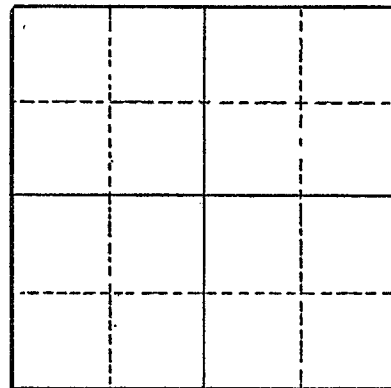

Section _____

CASING RECORD:

4-Inches
3-Inches

FINISH:

Perforations from 18 to 20

AQUIFERS:

Loam, soil and gravelly clay

WATER LEVEL:

8-Feet

PUMPING EQUIPMENT: Type Berkeley Centrifugal H.P. 15
Capacity 400 G.P.M.

WELL TESTS:

Drawdown 2 ft. after _____ hours Pumping 400 G.P.M.
Drawdown _____ ft. after _____ hours _____ G.P.M.

USE OF WATER Irrigation Temp. _____ °F. _____, 19____

SOURCE OF INFORMATION GR-2067

DRILLER or DIGGER _____

ADDITIONAL DATA:

Log Water Level Measurements _____ Chemical Analysis _____ Aquifer Test _____

REMARKS:

8
Loam top soil 5 12
Gravelly clay 12 0