

STATE OF OREGON  
WATER SUPPLY WELL REPORT  
(as required by ORS 537.765)

WELL I.D. # L 64796  
START CARD # 162886

Instructions for completing this report are on the last page of this form.

(1) LAND OWNER Well Number 2289  
Name Wally & Jackie Lucas  
Address 88520 Fisher Rd  
City Eugene State OR Zip 97402

(2) TYPE OF WORK  
 New Well  Deepening  Alteration (repair/recondition)  Abandonment

(3) DRILL METHOD:  
 Rotary Air  Rotary Mud  Cable  Auger  
 Other \_\_\_\_\_

(4) PROPOSED USE:  
 Domestic  Community  Industrial  Irrigation  
 Thermal  Injection  Livestock  Other \_\_\_\_\_

(5) BORE HOLE CONSTRUCTION:  
Special Construction approval  Yes  No Depth of Completed Well 100 ft.  
Explosives used  Yes  No Type \_\_\_\_\_ Amount \_\_\_\_\_

HOLE		SEAL		Sacks or pounds	
Diameter	From To	Material	From To		
10"	0' 19'	Bentonite	0' 19'	9	Sacks
6"	19' 100'				

How was seal placed: Method  A  B  C  D  E  
 Other Placed @ 1 Sack pr. 5 min. rate  
Backfill placed from \_\_\_\_\_ ft. to \_\_\_\_\_ ft. Material \_\_\_\_\_  
Gravel placed from \_\_\_\_\_ ft. to \_\_\_\_\_ ft. Size of gravel \_\_\_\_\_

(6) CASING/LINER:

Diameter	From	To	Gauge	Steel	Plastic	Welded	Threaded
Casing: 6"	11'	19'	250	<input checked="" type="checkbox"/>	<input type="checkbox"/>	<input type="checkbox"/>	<input type="checkbox"/>
Liner: 4"	0'	100'	160	<input type="checkbox"/>	<input checked="" type="checkbox"/>	<input type="checkbox"/>	<input type="checkbox"/>

Drive Shoe used  Inside  Outside  None  
Final location of shoe(s) \_\_\_\_\_

(7) PERFORATIONS/SCREENS:  
 Perforations Method Elect Saw  
 Screens Type \_\_\_\_\_ Material \_\_\_\_\_

From	To	Slot size	Number	Diameter	Tele/pipe size	Casing	Liner
20'	100'	4x4"	195			<input type="checkbox"/>	<input checked="" type="checkbox"/>

(8) WELL TESTS: Minimum testing time is 1 hour  
 Pump  Bailer  Air  Flowing  
Yield gal/min \_\_\_\_\_ Drawdown \_\_\_\_\_ Drill stem at \_\_\_\_\_ Time \_\_\_\_\_  
50 GPM \_\_\_\_\_ 100' \_\_\_\_\_ 1 hr.

Temperature of water 57° Depth Artesian Flow Found \_\_\_\_\_  
Was a water analysis done?  Yes By whom \_\_\_\_\_  
Did any strata contain water not suitable for intended use?  Too little  
 Salty  Muddy  Odor  Colored  Other \_\_\_\_\_  
Depth of strata: \_\_\_\_\_

(9) LOCATION OF WELL by legal description:  
County Lane Latitude \_\_\_\_\_ Longitude \_\_\_\_\_  
Township 17S N of 9 Range 05W E of W WM.  
Section 25 SW 1/4 NW 1/4  
Tax Lot 1801 Lot \_\_\_\_\_ Block \_\_\_\_\_ Subdivision \_\_\_\_\_  
Street Address of Well (or nearest address) Same


(10) STATIC WATER LEVEL:  
30 ft. below land surface. Date 5-7-04  
Artesian pressure \_\_\_\_\_ lb. per square inch Date \_\_\_\_\_

(11) WATER BEARING ZONES:  
Depth at which water was first found 35'

From	To	Estimated Flow Rate	SWL
35'	36'	5 GPM	30'
80'	81'	45 GPM	30'

(12) WELL LOG:  
Ground Elevation \_\_\_\_\_

Material	From	To	SWL
Topsoil	0	1	
Brown Clay	1	6	
Weathered Sandstone	6	10	
Grey Sandstone	10	83	30'
Blue-Grey Cong.	83	100	30'

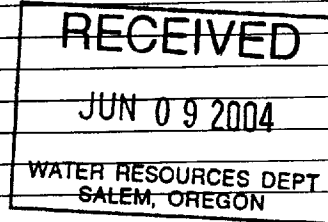

Date started 5-7-04 Completed 5-7-04

(unbonded) Water Well Constructor Certification:  
I certify that the work I performed on the construction, alteration, or abandonment of this well is in compliance with Oregon water supply well construction standards. Materials used and information reported above are true to the best of my knowledge and belief.  
Signed Sehuel P. Aldenit WWC Number 1742 Date 5/7/04

(bonded) Water Well Constructor Certification:  
I accept responsibility for the construction, alteration, or abandonment work performed on this well during the construction dates reported above. All work performed during this time is in compliance with Oregon water supply well construction standards. This report is true to the best of my knowledge and belief.  
Signed Donald J. Irving WWC Number 751 Date 5-7-04