

STATE ENGINEER  
Salem, Oregon

LANE  
0359

# Well Record

GR- 1149

STATE WELL NO. 15/4W-31D  
COUNTY Lane  
APPLICATION NO. GR- 1188

OWNER: Arnold R. Tracer


MAILING ADDRESS: Box 6

LOCATION OF WELL: Owner's No.

CITY AND STATE: Junction City, Oregon

NW 1/4 NW 1/4 Sec. 31 T. 15 S, R. 4 W., W.M.

Bearing and distance from section or subdivision  
corner 1320' E. & 750' S. of NW cor. Sec. 31.

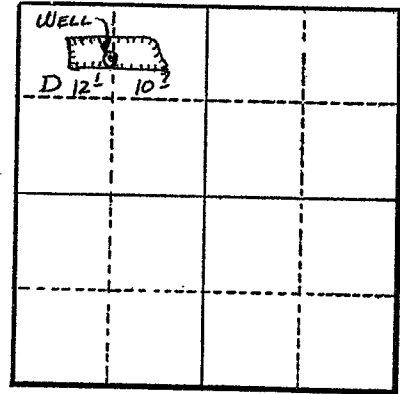

Section 31

Altitude at well 320 ft.

TYPE OF WELL: Driven Date Constructed 1951

Depth drilled 25 ft. Depth cased 25 ft.

### CASING RECORD:

4 inch

### FINISH:

### AQUIFERS:

### WATER LEVEL:

6 ft.

PUMPING EQUIPMENT: Type Cornell 1 1/4 in. Cent.

H.P. 7 1/2

Capacity 200 G.P.M.

### WELL TESTS:

Drawdown 10 ft. after 200 hours G.P.M.

Drawdown \_\_\_\_\_ ft. after \_\_\_\_\_ hours G.P.M.

USE OF WATER Irrigation Temp. \_\_\_\_\_ °F., 19

SOURCE OF INFORMATION G. R. Record

DRILLER or DIGGER Walter Nelson

### ADDITIONAL DATA:

Log N.A. Water Level Measurements \_\_\_\_\_ Chemical Analysis \_\_\_\_\_ Aquifer Test \_\_\_\_\_

### REMARKS:

Irrigation of 22.8 acres.