

STATE ENGINEER  
Salem, Oregon

LANE  
6367

# Well Record

STATE WELL NO. 15/4W-31L  
COUNTY Lane  
APPLICATION NO. GR-1250

GR- 1207

OWNER: Ralph G. Witcher


MAILING ADDRESS: 445 Oaklea Drive

LOCATION OF WELL: Owner's No.

CITY AND STATE: Junction City, Oregon

NE 1/4 SW 1/4 Sec. 31 T. 15 S., R. 4 W., W.M.

Bearing and distance from section or subdivision corner 2160' N. & 660' W. from SW cor. Sec. 31.

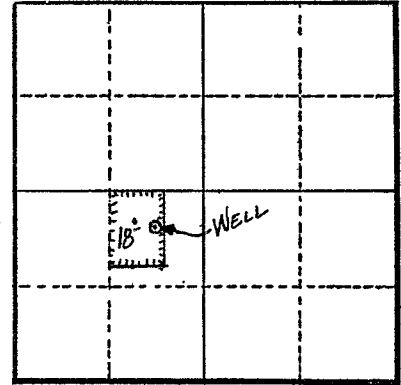

Section 31

Altitude at well 315 ft.

TYPE OF WELL: Drilled Date Constructed 1948

Depth drilled 65 ft. Depth cased 60 ft.

### CASING RECORD:

6 in. steel casing from 0 to 60 ft.

### FINISH:

Perforated with 1/4 x 4 in. holes (12 per ft.) from 20 to 60 ft.

### AQUIFERS:

### WATER LEVEL:

12 ft.

PUMPING EQUIPMENT: Type Pacific 3 in. H.P. 10  
Capacity 200 G.P.M.

### WELL TESTS:

Drawdown 8 ft. after 150 hours G.P.M.  
Drawdown ft. after hours G.P.M.

USE OF WATER Irrigation Temp. °F., 19

SOURCE OF INFORMATION G. R. Record

DRILLER or DIGGER Brandt Well Drilling

### ADDITIONAL DATA:

Log N. A. Water Level Measurements Chemical Analysis Aquifer Test

### REMARKS:

Irrigation of 18 acres.