


LANE
6368

Well Record

OWNER: Lane County School Dist. No. 69
Junior High School
LOCATION OF WELL: Owner's No. 2
MAILING ADDRESS: 5th and Maple Sts.
CITY AND STATE: Junction City, Oregon

SE 1/4 SE 1/4 Sec. 31 T. 15 S., R. 4 W., W.M.
Bearing and distance from section or subdivision
corner 310' W & 1000' N from SE corner Sec 31.
T. 15 S., R. 4 W.

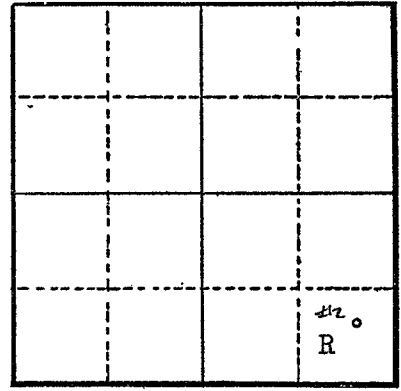

Section 31

Altitude at well

TYPE OF WELL: Driven Date Constructed 1953
Depth drilled 29' Depth cased 29'

CASING RECORD:

4-inch

FINISH:

24 perforation 1/4 x 4 in.
25 to 29

AQUIFERS:

Brown Loam, Sand, Gravel

WATER LEVEL:

10'

PUMPING EQUIPMENT: Type Cornell Centrifugal H.P. 7 1/2
Capacity 200 G.P.M.

WELL TESTS:

Drawdown 6 ft. after hours 400 G.P.M.
Drawdown ft. after hours G.P.M.

USE OF WATER Irrigation Temp. °F., 19

SOURCE OF INFORMATION GR-3993

DRILLER or DIGGER

ADDITIONAL DATA:

Log X Water Level Measurements Chemical Analysis Aquifer Test

REMARKS:

Brown Loam 0 to 10
Sand & Gravel 10 to 29