

STATE ENGINEER  
Salem, Oregon

LANE  
6401

# Well Record


STATE WELL NO. 15/LW-32B  
COUNTY Lane  
APPLICATION NO. GR-3613

OWNER: Lewis A. Bryson  
MAILING ADDRESS: 85 Dana Lane

LOCATION OF WELL: Owner's No. \_\_\_\_\_  
CITY AND STATE: Junction City, Oregon

NW ¼ NE ¼ Sec. 32 T. 15 S., R. 4 W., W.M.

Bearing and distance from section or subdivision  
corner 2300' W. and 976' S. from NE corner of Sec. 32

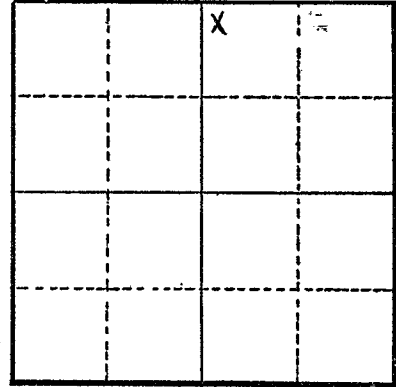

Section 32

Altitude at well \_\_\_\_\_

TYPE OF WELL: Driven Date Constructed 1942

Depth drilled 20 ft. Depth cased 20 ft.

### CASING RECORD:

2½ inch casing set to 20 feet

### FINISH:

2½ inch perforated well pipe from 17 to 20 feet

### AQUIFERS:

### WATER LEVEL:

15 feet below surface

PUMPING EQUIPMENT: Type Pacific centrifugal H.P. 3  
Capacity 80 G.P.M.

### WELL TESTS:

Drawdown \_\_\_\_\_ ft. after \_\_\_\_\_ hours \_\_\_\_\_ G.P.M.

Drawdown \_\_\_\_\_ ft. after \_\_\_\_\_ hours \_\_\_\_\_ G.P.M.

USE OF WATER Irrigation Temp. \_\_\_\_\_ °F., 19

SOURCE OF INFORMATION Well Registration Statement

DRILLER or DIGGER Walter Nelson

### ADDITIONAL DATA:

Log \_\_\_\_\_ Water Level Measurements \_\_\_\_\_ Chemical Analysis \_\_\_\_\_ Aquifer Test \_\_\_\_\_

### REMARKS: