

STATE ENGINEER
Salem, Oregon

LANE
6402

Well Record


STATE WELL NO. 15/4W-32D
COUNTY LANE
APPLICATION NO. GR-2754

OWNER: Olga M. Martensen
MAILING ADDRESS: 1700 Deal Street

LOCATION OF WELL: Owner's No. _____
CITY AND STATE: Junction City, Oregon

NW 1/4 NW 1/4 Sec. 32 T. 15 N S., R. 4 E W., W.M.

Bearing and distance from section or subdivision
corner 760' S. and 230' E.

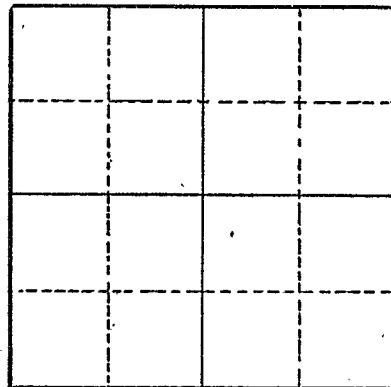

Section _____

Altitude at well _____

TYPE OF WELL: driven Date Constructed 1948

Depth drilled 21.5 Depth cased _____

CASING RECORD:

FINISH:

AQUIFERS:

WATER LEVEL:

11-feet

PUMPING EQUIPMENT: Type Pacific Centrifugal H.P. 10
Capacity 150 G.P.M.

WELL TESTS:

Drawdown 3.0 ft. after _____ hours Pumping 200 G.P.M.

Drawdown _____ ft. after _____ hours _____ G.P.M.

USE OF WATER irrigation Temp. _____ °F. _____, 19

SOURCE OF INFORMATION GR-2604

DRILLER or DIGGER Walter Nelson, Junction City, Oregon

ADDITIONAL DATA:

Log _____ Water Level Measurements _____ Chemical Analysis _____ Aquifer Test _____

REMARKS: