

STATE ENGINEER
Salem, Oregon

LANE
0403

Well Record

STATE WELL NO. 15/4-32E
COUNTY Lane
APPLICATION NO. GR-3611

OWNER: Lane County School Dist. No. 69
Elementary


MAILING ADDRESS: 1401 Laurel St.

LOCATION OF WELL: Owner's No. _____

CITY AND STATE: Junction City, Oregon

SW 1/4 NW 1/4 Sec. 32 T. 15 S., R. 4 W., W.M.

Bearing and distance from section or subdivision
corner 1382' S & 70' E from NW corner Sec 32

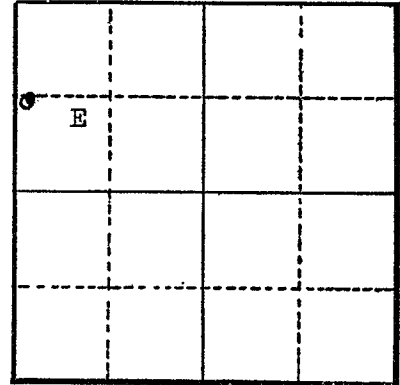

Section 32

Altitude at well _____

TYPE OF WELL: Driven Date Constructed 1954

Depth drilled 29' Depth cased 28'

CASING RECORD:

4-inch

FINISH:

24 perforation
24 to 28

AQUIFERS:

Brown Loam, Sand, Gravel

WATER LEVEL:

10'

PUMPING EQUIPMENT: Type Jacuzzi Centrifugal H.P. 7 1/2
Capacity 200 G.P.M.

WELL TESTS:

Drawdown 8 ft. after _____ hours 200 G.P.M.

Drawdown _____ ft. after _____ hours _____ G.P.M.

USE OF WATER Irrigation Temp. °F. 19

SOURCE OF INFORMATION GR-3992

DRILLER or DIGGER _____

ADDITIONAL DATA:

Log Water Level Measurements _____ Chemical Analysis _____ Aquifer Test _____

REMARKS:

Brown Loam 0 to 12
Sand & Gravel 12 to 28