


LANE
6404

Well Record

OWNER: Mrs. Nora Pitney MAILING ADDRESS: 4170 Oakman Street

LOCATION OF WELL: Owner's No. CITY AND STATE: Salem, Oregon

SW 1/4 NE 1/4 Sec. 32 T. 15 N. S. R. 4 E. W.M.
Bearing and distance from section or subdivision
corner 510 feet North and 300 feet East from the
center of Section 32.

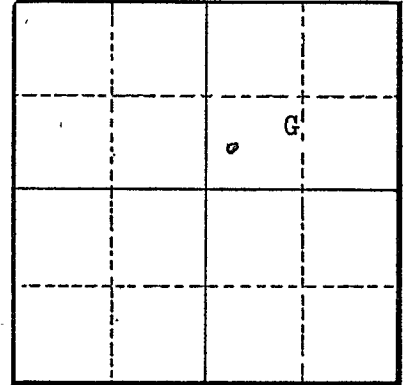

Section 32

Altitude at well 400 feet

TYPE OF WELL: Drilled Date Constructed 3-15-48
Depth drilled 22 feet Depth cased 22 feet

CASING RECORD:

3-inch casing set from 0 to 22 feet
(pipe)

FINISH:

sand point

AQUIFERS:

sand and gravels

WATER LEVEL:

12 feet

PUMPING EQUIPMENT: Type Fairbank Morse Centrifical 1 1/2" H.P.
Capacity 150 G.P.M.

WELL TESTS:

Drawdown ft. after hours 250 G.P.M.
Drawdown ft. after hours G.P.M.

USE OF WATER Irrigation Temp. °F., 19

SOURCE OF INFORMATION GR-4072

DRILLER or DIGGER Melvin R. Andrews Salem, Oregon

ADDITIONAL DATA:

Log (NA) Water Level Measurements Chemical Analysis Aquifer Test

REMARKS: