

STATE ENGINEER  
Salem, Oregon

LANE  
20405

# Well Record

STATE WELL NO. 15/4W-32G  
COUNTY Lane  
APPLICATION NO. GR-1341

GR- 1297

OWNER: Fred Petersen

MAILING ADDRESS:

204 Dane Lane


LOCATION OF WELL: Owner's No.

CITY AND STATE:

Junction City, Oregon

SW 1/4 NE 1/4 Sec. 32 T. 15 S., R. 4 W., W.M.

Bearing and distance from section or subdivision corner 4025' S66°30'E. from NW cor. Sec. 32.

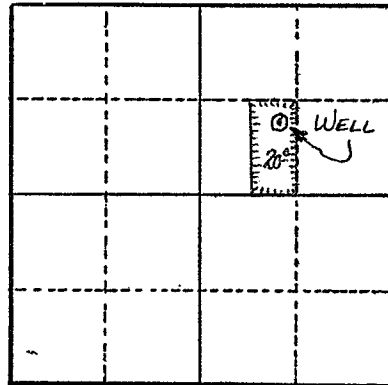

Section 32

Altitude at well

TYPE OF WELL: Drilled Date Constructed 1945

Depth drilled 27 ft. Depth cased 27 ft.

### CASING RECORD:

4 inch

### FINISH:

Perforated: 3 slots/ft. from 24 to 27 ft.

### AQUIFERS:

### WATER LEVEL:

12 ft.

PUMPING EQUIPMENT: Type Pacific 2 in. Cent.

H.P. 10

Capacity 350 G.P.M.

### WELL TESTS:

Drawdown ft. after hours G.P.M.

Drawdown ft. after hours G.P.M.

USE OF WATER Irrigation

Temp. °F. 19

SOURCE OF INFORMATION G.R. Record

DRILLER or DIGGER

### ADDITIONAL DATA:

Log N.A. Water Level Measurements Chemical Analysis Aquifer Test

### REMARKS:

Irrigation of 20 acres.