

STATE ENGINEER
Salem, Oregon

LANE
6407

Well Record

STATE WELL NO. 15/4W-32H
COUNTY Lane
APPLICATION NO. GR-2934

OWNER: John A. Hentze
MAILING ADDRESS: 294 Dana Lane

LOCATION OF WELL: Owner's No.
CITY AND STATE: Junction City, Oregon


SE 1/4 NE 1/4 Sec. 32 T. 15 N. S. R. 4 W., W.M.

Bearing and distance from section or subdivision
corner 1750' S. and 1200' W. from the N.E.
corner of Section 32

Altitude at well

TYPE OF WELL: drilled Date Constructed 1955

Depth drilled 30 Depth cased

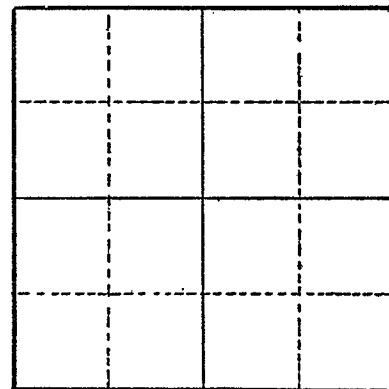

Section

CASING RECORD:

FINISH:

4" perforated regular screen, from 26 to 30

AQUIFERS:

Loam, clay, sand, and gravel

WATER LEVEL:

15 feet

PUMPING EQUIPMENT: Type Jacuzzi H.P. 7 1/2
Capacity 250 G.P.M.

WELL TESTS:

Drawdown 4 ft. after hours Pumping 250+ G.P.M.
Drawdown ft. after hours G.P.M.

USE OF WATER Irrigation Temp. °F., 19

SOURCE OF INFORMATION GR-2830

DRILLER or DIGGER

ADDITIONAL DATA:

Log X Water Level Measurements Chemical Analysis Aquifer Test

REMARKS:

Silt loam	0	4	4
Silty clay	4	5	1
Sand and gravel	5	30	25