

STATE ENGINEER
Salem, Oregon

LANE
6409

Well Record

STATE WELL NO. 15/~~4W~~-32L
COUNTY LANE
APPLICATION NO. GR-4128

OWNER: City of Junction City

MAILING
ADDRESS: _____


LOCATION OF WELL: Owner's No. _____

CITY AND
STATE: _____

Oregon

NE $\frac{1}{4}$ SW $\frac{1}{4}$ Sec. 32 T. 15 S., R. 4 W., W.M.

Bearing and distance from section or subdivision
corner 1950' N & 1800' E from SW cor Sec 32

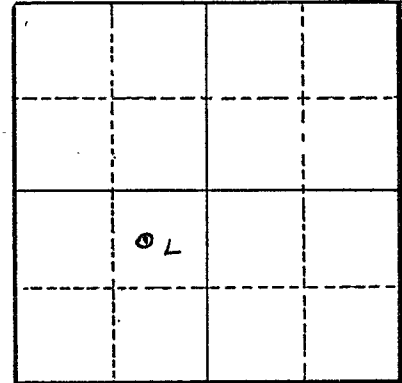

Section 32

Altitude at well _____

TYPE OF WELL: Drilled Date Constructed 1938

Depth drilled 140' Depth cased top to bottom

CASING RECORD:

8-inch

FINISH:

AQUIFERS:

sand gravel

WATER LEVEL:

12'

PUMPING EQUIPMENT: Type Peerless Turbine H.P. 15
Capacity 160 G.P.M.

WELL TESTS:

Drawdown 23 ft. after _____ hours 160 G.P.M.
Drawdown _____ ft. after _____ hours _____ G.P.M.

USE OF WATER Municipal Temp. _____ °F., 19

SOURCE OF INFORMATION GR-3978

DRILLER or DIGGER _____

ADDITIONAL DATA:

Log _____ Water Level Measurements _____ Chemical Analysis _____ Aquifer Test _____

REMARKS: