

STATE ENGINEER
Salem, Oregon

LANE
6410

Well Record

STATE WELL NO. 15/4W-32L(2)
COUNTY LANE
APPLICATION NO. GR-4123

OWNER: City of Junction City


MAILING ADDRESS:

LOCATION OF WELL: Owner's No.

CITY AND STATE: Oregon

NE 1/4 SW 1/4 Sec. 32 T. 15 S., R. 4 W., W.M.

Bearing and distance from section or subdivision corner about 1820' E and 470' S from W 1/4 cor Sec 32

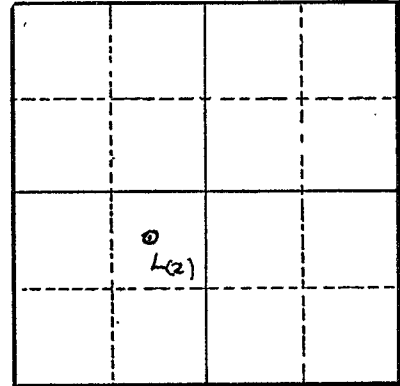

Section 32

Altitude at well

TYPE OF WELL: Drilled Date Constructed 1940

Depth drilled 120' Depth cased top to bottom

CASING RECORD:

8-inch

FINISH:

AQUIFERS:

sand & gravel

WATER LEVEL:

12'

PUMPING EQUIPMENT: Type Pomona Turbine

H.P. 15

Capacity 160 G.P.M.

WELL TESTS:

Drawdown 23 ft. after hours 160 G.P.M.

Drawdown ft. after hours G.P.M.

USE OF WATER Municipal Temp. °F., 19

SOURCE OF INFORMATION GR-3979

DRILLER or DIGGER

ADDITIONAL DATA:

Log Water Level Measurements Chemical Analysis Aquifer Test

REMARKS: