

STATE ENGINEER  
Salem, Oregon

LANE  
0411

# Well Record


STATE WELL NO. 15/4W-32L(3)  
COUNTY LANE  
APPLICATION NO. GR-4124

OWNER: City of Junction City MAILING ADDRESS:

LOCATION OF WELL: Owner's No. CITY AND STATE: Junction City, Oregon

NE 1/4 SW 1/4 Sec. 32 T. 15 S., R. 4 W., W.M.

Bearing and distance from section or subdivision corner 1820' E & 585' S from W 1/4 cor Sec 32

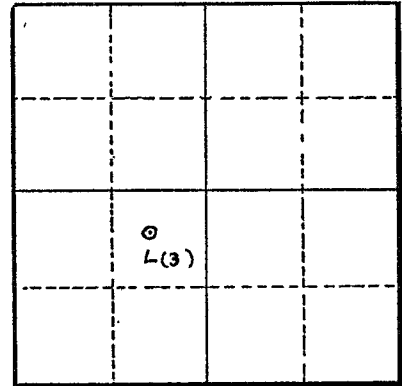

Section 32

Altitude at well

TYPE OF WELL: Drilled Date Constructed 1942

Depth drilled 79' Depth cased top to bottom

### CASING RECORD:

10-inch

### FINISH:

### AQUIFERS:

sand gravel & clay

### WATER LEVEL:

12'

PUMPING EQUIPMENT: Type Fairbanks Morse H.P. 20  
Capacity 300 G.P.M.

WELL TESTS:  
Drawdown 23 ft. after 300 hours G.P.M.  
Drawdown ft. after hours G.P.M.

USE OF WATER Municipal Temp. °F., 19

SOURCE OF INFORMATION GR-3980

DRILLER or DIGGER

ADDITIONAL DATA:  
Log Water Level Measurements Chemical Analysis Aquifer Test

### REMARKS: