

STATE ENGINEER
Salem, Oregon

LANE
6414

Well Record

STATE WELL NO. 15/4W-32Q
COUNTY LANE
APPLICATION NO. GR-4125

OWNER: City of Junction City


MAILING ADDRESS: Junction City

LOCATION OF WELL: Owner's No.

CITY AND STATE: Oregon

SW 1/4 SE 1/4 Sec. 32 T. 15 S., R. 4 W., W.M.

Bearing and distance from section or subdivision corner 380' E & 960' N from S¹/₄ cor. Sec. 32

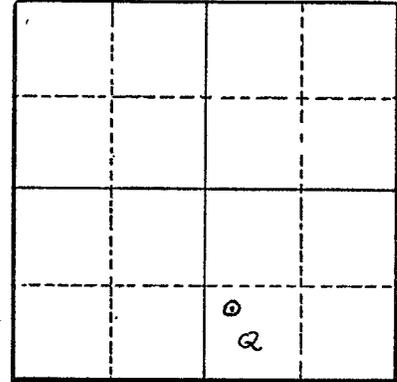

Section 32

Altitude at well

TYPE OF WELL: Driven Date Constructed 1952

Depth drilled 32' Depth cased top to bottom

CASING RECORD:

5-inch
4-inch

FINISH:

8 1/4 28' to 32'

AQUIFERS:

sand, gravel, hard pan

WATER LEVEL:

12'

PUMPING EQUIPMENT: Type Cornell Centrifugal H.P. 30
Capacity 400 G.P.M.

WELL TESTS:

Drawdown 10 ft. after hours 350 G.P.M.

Drawdown ft. after hours G.P.M.

USE OF WATER Municipal Temp. °F. 19

SOURCE OF INFORMATION GR-3981

DRILLER or DIGGER

ADDITIONAL DATA:

Log ^X Water Level Measurements Chemical Analysis Aquifer Test

REMARKS:

Sand & gravel 6'
Hard pan clay 4'
Gravel 6'