

STATE ENGINEER
Salem, Oregon

LANE
6415

Well Record

GR- 1318

STATE WELL NO. 15/4W-32R
COUNTY Lane
APPLICATION NO. GR- 1200

OWNER: EJNER P. CHRISTIANSON


MAILING ADDRESS: 333 River Rd.

LOCATION OF WELL: Owner's No.

CITY AND STATE: Junction City, Oregon

SE 1/4 SE 1/4 Sec. 32 T. 15 S., R. 4 W., W.M.

Bearing and distance from section or subdivision corner 550' N. & 570' W. from SE cor. Sec. 32.

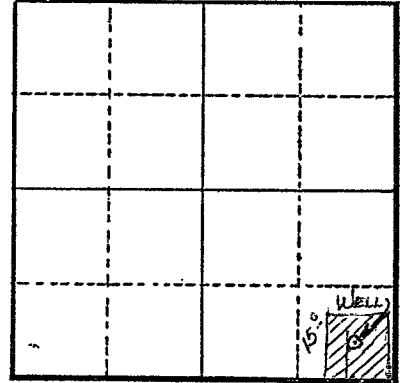

Section 32

Altitude at well

TYPE OF WELL: Driven Date Constructed 1947

Depth drilled 25 ft. Depth cased 25 ft.

CASING RECORD:

3 inch

FINISH:

Perforated from 21 to 25 ft.

AQUIFERS:

WATER LEVEL:

6 ft/

PUMPING EQUIPMENT: Type Belt driven Cent. H.P. 9

Capacity 100 G.P.M.

WELL TESTS:

Drawdown 2 ft. after 50 hours G.P.M.

Drawdown ft. after hours G.P.M.

USE OF WATER Irrigation Temp. °F., 19

SOURCE OF INFORMATION G. R. Record

DRILLER or DIGGER

ADDITIONAL DATA:

Log Water Level Measurements Chemical Analysis Aquifer Test

REMARKS:

Log: Willamette loam 0 to 4 ft.
Gravel 4 to 25 ft.

Irrigation of 15 acres.