

STATE ENGINEER  
Salem, Oregon

LANE  
6437

# Well Record

GR- 1078

STATE WELL NO. 15/4W-33A(1)  
COUNTY Lane  
APPLICATION NO. GR- 1118

OWNER: Thorvald C. Andersen

MAILING ADDRESS: 590 Willamette Drive


LOCATION OF WELL: Owner's No. #2

CITY AND STATE: Junction City, Oregon

NE 1/4 NE 1/4 Sec. 33 T. 15 S., R. 4 W., W.M.

Bearing and distance from section or subdivision

corner 4267.22' N3°46'W. of SE cor. Sec. 33.

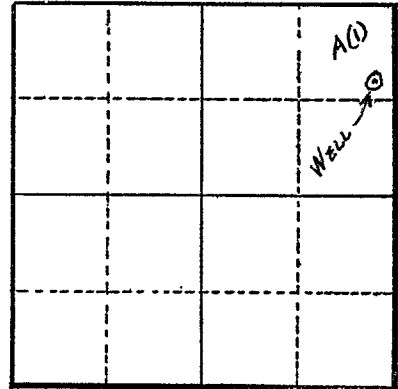

Section 33

Altitude at well 324 ft.

TYPE OF WELL: Driven Date Constructed 1940

Depth drilled 22 ft. Depth cased 22 ft.

### CASING RECORD:

2 - 3 inch

### FINISH:

Perforated from 19 to 22 ft.

### AQUIFERS:

### WATER LEVEL:

8 ft.

PUMPING EQUIPMENT: Type A. G. Cent. H.P. 15  
Capacity 375 G.P.M.

### WELL TESTS:

Drawdown ft. after hours G.P.M.

Drawdown ft. after hours G.P.M.

USE OF WATER Irrigation Temp. °F. 19

SOURCE OF INFORMATION G. R. Record

DRILLER or DIGGER

### ADDITIONAL DATA:

Log N.A. Water Level Measurements Chemical Analysis Aquifer Test

### REMARKS:

Irrigation of 52.31 acres.