

STATE ENGINEER  
Salem, Oregon

LANE  
6441

# Well Record

STATE WELL NO. 15/4W-3853  
COUNTY Lane  
APPLICATION NO. GR-2180

OWNER: Hans A. Rasmussen


MAILING ADDRESS: Box 157

LOCATION OF WELL: Owner's No.

CITY AND STATE: Junction City, Oregon

NW 1/4 NW 1/4 Sec. 33 T. 15 S., R. 4 W., W.M.

Bearing and distance from section or subdivision  
corner 640' S & 1270' E from NW corner Section 33

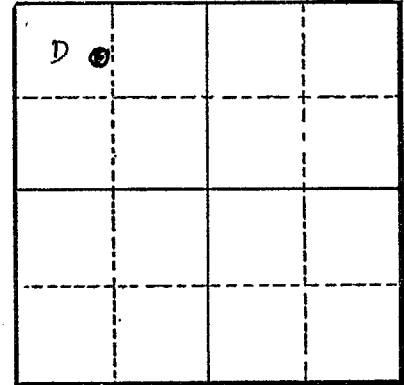

Section 33

Altitude at well

TYPE OF WELL: Driven Date Constructed 1949

Depth drilled 26' Depth cased 26'

### CASING RECORD:

4-inch

### FINISH:

Lower 4' perforated with 3-in slots

### AQUIFERS:

### WATER LEVEL:

18'

PUMPING EQUIPMENT: Type Cornell H.P. 20  
Capacity 500 G.P.M.

### WELL TESTS:

Drawdown ft. after hours G.P.M.  
Drawdown ft. after hours G.P.M.

USE OF WATER Irrigation Temp. °F., 19

SOURCE OF INFORMATION GR-3853

DRILLER or DIGGER

### ADDITIONAL DATA:

Log <sup>x</sup> Water Level Measurements Chemical Analysis Aquifer Test

### REMARKS:

Driven Well