

STATE ENGINEER  
Salem, Oregon

LANE  
6444

# Well Record

STATE WELL NO. 15/4W-33F  
COUNTY Lane  
APPLICATION NO. GR-3267

OWNER: Aage Gribskov


MAILING ADDRESS: Junction City

LOCATION OF WELL: Owner's No.

CITY AND STATE: Oregon

SE 1/4 NW 1/4 Sec. 33 T. 15 S., R. 4 W., W.M.

Bearing and distance from section or subdivision corner 4340' N 29° 30' E SW cor. Sec. 33

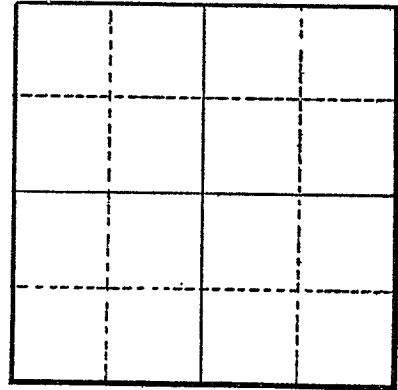

Section

Altitude at well

TYPE OF WELL: driven Date Constructed 1945

Depth drilled 22 Depth cased 22

### CASING RECORD:

4 inch

### FINISH:

Standard perforations from 18 to 22

### AQUIFERS:

Soil, sand and gravel

### WATER LEVEL:

12 feet

PUMPING EQUIPMENT: Type Fairbanks Morse, Cent. H.P. 10  
Capacity 500 G.P.M.

### WELL TESTS:

Drawdown 3 ft. after hours Pumping 350 G.P.M.  
Drawdown ft. after hours G.P.M.

USE OF WATER Irrigation Temp. °F. 19

SOURCE OF INFORMATION GR-3039

DRILLER or DIGGER

### ADDITIONAL DATA:

Log  Water Level Measurements Chemical Analysis Aquifer Test

### REMARKS:

Top soil (loam)	6	16
Sand and gravel	16	0