

STATE ENGINEER
Salem, Oregon

LANE Well Record

6446

STATE WELL NO. 15/4W-33H
COUNTY Lane
APPLICATION NO. GR-912

OWNER: Bennie Jensen


MAILING ADDRESS: 300 Willamette Dr.

LOCATION OF WELL: Owner's No.

CITY AND STATE: Junction City, Oregon

SE 1/4 NE 1/4 Sec. 33 T. 15 S., R. 4 W., W.M.

Bearing and distance from section or subdivision corner 3434.42' N. 10° 27' 30" W. of SE cor. Sec. 33

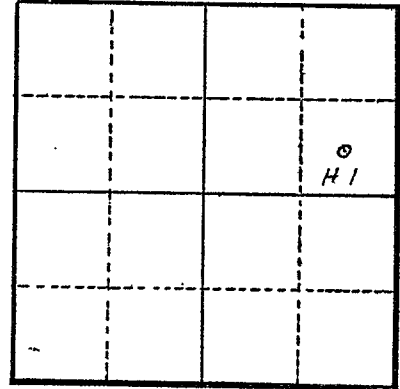

Section 33

Altitude at well 323 ft.

TYPE OF WELL: driven Date Constructed 1937

Depth drilled 30 ft. Depth cased 30 ft.

CASING RECORD: 4 in. steel 0 ft. - 30 ft.

FINISH: Perforated from 27 ft. - 30 ft.

AQUIFERS: Sand & gravel

WATER LEVEL: 10 ft.

PUMPING EQUIPMENT: Type A. C. centrifugal H.P. 15
Capacity 475 G.P.M.

WELL TESTS: No test
Drawdown ft. after hours G.P.M.
Drawdown ft. after hours G.P.M.

USE OF WATER irrigation Temp. °F. 19

SOURCE OF INFORMATION owner

DRILLER or DIGGER

ADDITIONAL DATA:

Log Water Level Measurements Chemical Analysis Aquifer Test

REMARKS: Log: Sand & gravel 0 ft. - 30 ft.