

STATE ENGINEER
Salem, Oregon

LANE
6448

Well Record

STATE WELL NO. 15/4W-33J
COUNTY Lane
APPLICATION NO. GR-911

OWNER: Brockner Mikkelsen


MAILING ADDRESS: 174 Willamette Dr.

LOCATION OF WELL: Owner's No. 2

CITY AND STATE: Junction City, Oregon

NE 1/4 SE 1/4 Sec. 33 T. 15 S, R. 4 W., W.M.

Bearing and distance from section or subdivision
corner 2497.66' N. 20° 56' W. of SE cor. Sec. 33

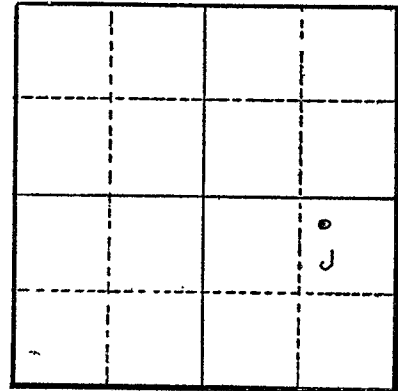

Section 33

Altitude at well 325

TYPE OF WELL: driven Date Constructed April 1952

Depth drilled 30 Depth cased 30

CASING RECORD: 4 in. steel 0 ft. - 30 ft.

FINISH: Perforations 27 ft. - 30 ft.

AQUIFERS: Sand & gravel 20 ft. - 30 ft.

WATER LEVEL: 10 ft.

PUMPING EQUIPMENT: Type centrifugal H.P. 5 elec.
Capacity 200 G.P.M.

WELL TESTS: No test
Drawdown ft. after hours G.P.M.
Drawdown ft. after hours G.P.M.

USE OF WATER irrigation Temp. °F. 19

SOURCE OF INFORMATION owner

DRILLER or DIGGER

ADDITIONAL DATA:
Log Water Level Measurements Chemical Analysis Aquifer Test

REMARKS: Log: Sand & gravel 0 ft. - 30 ft.