

STATE ENGINEER
Salem, Oregon

LANE
6449

Well Record

STATE WELL NO. 15/LAW-33K(1)
COUNTY Lane
APPLICATION NO. GR-1194

GR- 1155

OWNER: Andrew Bodtker

MAILING
ADDRESS:

Lovelake Rd.

LOCATION OF WELL: Owner's No.


CITY AND
STATE:

Junction City, Oregon

NW 1/4 SE 1/4 Sec. 33 T. 15 S. R. 4 W., W.M.

Bearing and distance from section or subdivision

corner 2713' N. 36°34'15" W. of SE cor. Sec. 33.

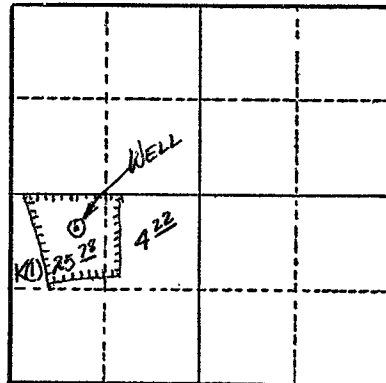

Section 33

Altitude at well 325 ft.

TYPE OF WELL: Driven Date Constructed 1942

Depth drilled 22 ft. Depth cased 22 ft.

CASING RECORD:

2 - 3 in pipes

FINISH:

Perforated with 2 slots per ft. from 19 to 22 ft.

AQUIFERS:

WATER LEVEL:

PUMPING EQUIPMENT: Type Cornell 2 1/2 x 3 in. Cent. H.P. 10
Capacity 300 G.P.M.

WELL TESTS:

Drawdown ft. after hours G.P.M.

Drawdown ft. after hours G.P.M.

USE OF WATER Irrigation Temp. °F., 19

SOURCE OF INFORMATION G. R. Record

DRILLER or DIGGER

ADDITIONAL DATA:

Log N.A. Water Level Measurements Chemical Analysis Aquifer Test

REMARKS:

Irrigation of 30 acres.