

STATE ENGINEER
Salem, Oregon

LANE
6450

Well Record

STATE WELL NO. 15/4W-33L
COUNTY LANE
APPLICATION NO. GR-2450

OWNER: Theo. M. McGill


MAILING ADDRESS: Rt. 2,

LOCATION OF WELL: Owner's No.

CITY AND STATE: Junction City, Oregon

NE 1/4 SW 1/4 Sec. 33 T. 15 N. S., R. 4 W., W.M.

Bearing and distance from section or subdivision corner 1600' N. & 2325' E.

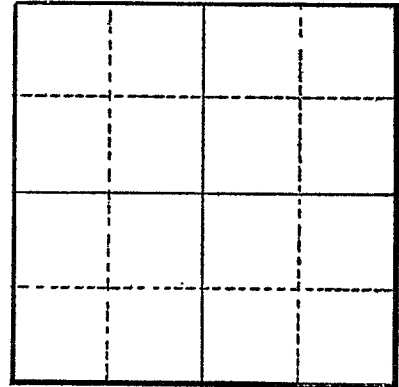

Section

Altitude at well

TYPE OF WELL: Drilled Date Constructed 1953

Depth drilled 30 Depth cased 30

CASING RECORD:

8-inch

FINISH:

Standard perforations from 25' to 30'

AQUIFERS:

Loam, sand, gravel and rock

WATER LEVEL:

8-feet

PUMPING EQUIPMENT: Type Cornell Centrifugal

H.P. 15

Capacity 350 G.P.M.

WELL TESTS:

Drawdown 4 ft. after hours Pumping 600 G.P.M.

Drawdown ft. after hours G.P.M.

USE OF WATER Irrigation

Temp. °F. 19

SOURCE OF INFORMATION GR-2322

DRILLER or DIGGER

ADDITIONAL DATA:

Log Water Level Measurements Chemical Analysis Aquifer Test

REMARKS:

Loam	4	26
Sand & Coarse gravel	21	5
Rock	5	0