

STATE ENGINEER  
Salem, Oregon

# LANE Well Record

STATE WELL NO. 15/4W-33L  
COUNTY Lane  
APPLICATION NO. GR-1374


GR- 1402

OWNER: James B. & Sarah Frances Crowson MAILING ADDRESS: 525 Love Lake Rd.

LOCATION OF WELL: Owner's No. \_\_\_\_\_ CITY AND STATE: Junction City, Oregon

NE 1/4 SW 1/4 Sec. 33 T. 15 S., R. 4 W., W.M.

Bearing and distance from section or subdivision  
corner 2250' N. & 2300' E. from SW cor. Sec. 33

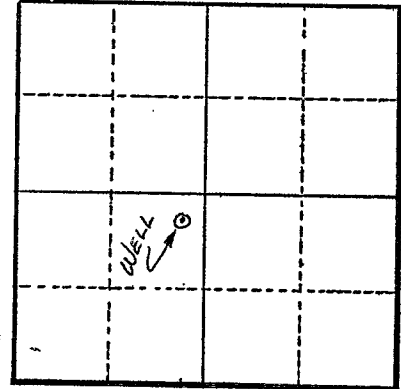

Section 33

Altitude at well 319'

TYPE OF WELL: Driven Date Constructed 1953

Depth drilled 24' Depth cased 24'

CASING RECORD:

5"

FINISH:

Standard perforations from 21' to 24'

AQUIFERS:

WATER LEVEL:

14'

PUMPING EQUIPMENT: Type Cornell 3" Cent. H.P. 20  
Capacity 370 G.P.M.

WELL TESTS:

Drawdown 1 ft. after \_\_\_\_\_ hours 370 G.P.M.

Drawdown \_\_\_\_\_ ft. after \_\_\_\_\_ hours \_\_\_\_\_ G.P.M.

USE OF WATER Irrigation Temp. \_\_\_\_\_ °F. \_\_\_\_\_, 19

SOURCE OF INFORMATION GR Record

DRILLER or DIGGER \_\_\_\_\_

ADDITIONAL DATA:

Log N.A. Water Level Measurements \_\_\_\_\_ Chemical Analysis \_\_\_\_\_ Aquifer Test \_\_\_\_\_

REMARKS:

Irrigation of 24.5 acres.