

STATE ENGINEER
Salem, Oregon

LANE
6453

Well Record

GR- 1477

STATE WELL NO. 15/4W-33P
COUNTY Lane
APPLICATION NO. GR- 1534

OWNER: F. Winther Bodtken


MAILING ADDRESS: 701 River Rd.

LOCATION OF WELL: Owner's No. _____

CITY AND STATE: Junction City, Oregon

SE ¼ SW ¼ Sec. 33 T. 15 S., R. 4 W., W.M.

Bearing and distance from section or subdivision corner 1560' E. & 285' N. from SW cor. Sec. 33

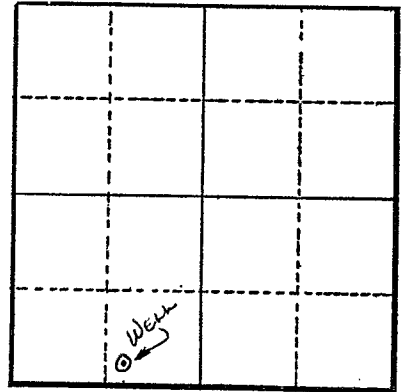

Altitude at well 320'

TYPE OF WELL: Driven Date Constructed 1947

Depth drilled 26' Depth cased 26'

Section 33

CASING RECORD:

3"

FINISH:

Perforated from 24' to 26'

AQUIFERS:

WATER LEVEL:

18'

PUMPING EQUIPMENT: Type Westinghouse

H.P. 3

Capacity 100 G.P.M.

WELL TESTS:

Drawdown 1 ft. after _____ hours 100 G.P.M.

Drawdown _____ ft. after _____ hours _____ G.P.M.

USE OF WATER Irrigation

Temp. _____ °F. _____, 19

SOURCE OF INFORMATION GR Record

DRILLER or DIGGER _____

ADDITIONAL DATA:

Log _____ Water Level Measurements _____ Chemical Analysis _____ Aquifer Test _____

REMARKS:

Log: Stratified sandy loam & silt loam 0 to 16 ft.
Cemented sand 16 to 18 ft.
Gravel 18 to 26 ft.

Irrigation of 6 acres.