

STATE ENGINEER  
Salem, Oregon

**LANE**  
6454

# Well Record

GR- 1492

STATE WELL NO. 15/4W-33P  
COUNTY Lane  
APPLICATION NO. GR- 1547

OWNER: Herman Kunkel

MAILING ADDRESS: 765 River Rd.


LOCATION OF WELL: Owner's No. #2

CITY AND STATE: Junction City, Oregon

SE 1/4 SW 1/4 Sec. 33 T. 15 S., R. 4 W., W.M.

Bearing and distance from section or subdivision

corner 4 1/2 ch. N. & 33 ch. E. from SW cor. Sec. 33

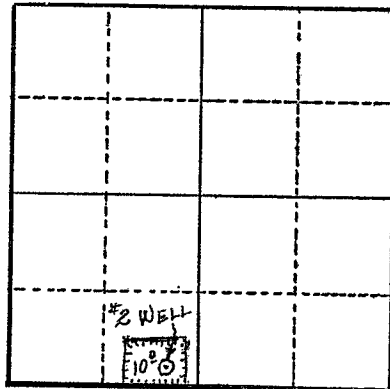

Section 33

Altitude at well

TYPE OF WELL: Drilled Date Constructed 1946

Depth drilled 20' Depth cased 20'

CASING RECORD:

4"

FINISH:

Perforated: 3" x 3" from 3 to 4 ft.

AQUIFERS:

WATER LEVEL:

15'

PUMPING EQUIPMENT: Type Cornell

H.P. 5

Capacity 250 G.P.M.

WELL TESTS:

Drawdown \_\_\_\_\_ ft. after \_\_\_\_\_ hours \_\_\_\_\_ G.P.M.

Drawdown \_\_\_\_\_ ft. after \_\_\_\_\_ hours \_\_\_\_\_ G.P.M.

USE OF WATER Irrigation

Temp. \_\_\_\_\_ °F. \_\_\_\_\_, 19

SOURCE OF INFORMATION GR Record

DRILLER or DIGGER Owner

ADDITIONAL DATA:

Log N.A. Water Level Measurements \_\_\_\_\_ Chemical Analysis \_\_\_\_\_ Aquifer Test \_\_\_\_\_

REMARKS:

Irrigation of 10 acres.