

STATE ENGINEER  
Salem, Oregon

LANE  
6456

# Well Record


STATE WELL NO. 15/4W-33R(1)  
COUNTY Lane  
APPLICATION NO. GR-640

OWNER: Ejner Hentze MAILING ADDRESS: 210 Hentze Lane

LOCATION OF WELL: Owner's No. 2 CITY AND STATE: Junction City, Oregon

SE  $\frac{1}{4}$  SE  $\frac{1}{4}$  Sec. 33 T. 15 S., R. 4 W., W.M.

Bearing and distance from section or subdivision corner 1107.33 ft. N. 8° 13' W. of SE cor. Sec. 33

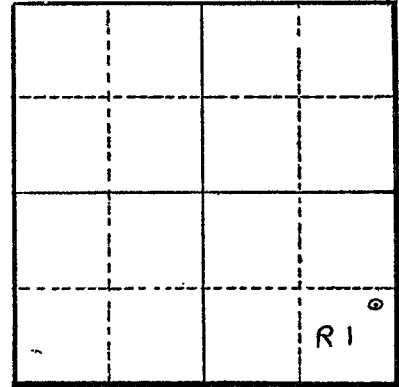

Section 3

Altitude at well 328

TYPE OF WELL: driven Date Constructed 1941

Depth drilled 30 Depth cased 30

CASING RECORD: 4-3-2 inch

FINISH:

AQUIFERS:

WATER LEVEL: 10 ft.

PUMPING EQUIPMENT: Type centrifugal H.P. 20  
Capacity 450 G.P.M.

WELL TESTS:  
Drawdown ..... ft. after ..... hours ..... G.P.M.  
Drawdown ..... ft. after ..... hours ..... G.P.M.

USE OF WATER irrigation 56 acres Temp. ..... °F. ...., 19

SOURCE OF INFORMATION GR-640

DRILLER or DIGGER .....

ADDITIONAL DATA:  
Log ..... Water Level Measurements ..... Chemical Analysis ..... Aquifer Test .....

REMARKS: