

STATE ENGINEER  
Salem, Oregon

LANE  
6457

# Well Record


STATE WELL NO. 15/4-33R(2)  
COUNTY Lane  
APPLICATION NO. GR-641

OWNER: Ejner Hentze  
MAILING ADDRESS: 210 Hentze Lane

LOCATION OF WELL: Owner's No. 3  
CITY AND STATE: Junction City, Oregon

SE 1/4 SE 1/4 Sec. 33 T. 15 S., R. 4 W., W.M.

Bearing and distance from section or subdivision  
corner 1035.4 ft. N. 54° 24' 30" W. of SE cor.  
Sec. 33

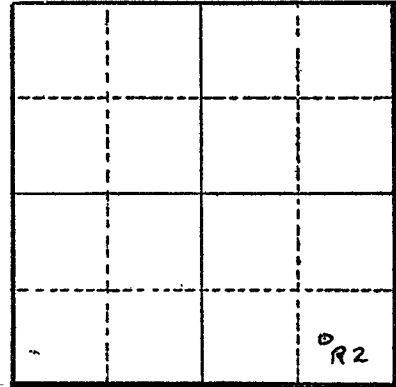

Section 33

Altitude at well 326

TYPE OF WELL: driven Date Constructed 1941

Depth drilled 30 Depth cased 30

CASING RECORD: 3 - 4 inch

FINISH:

AQUIFERS:

WATER LEVEL: 10 ft.

PUMPING EQUIPMENT: Type centrifugal H.P. 60  
Capacity 600 G.P.M.

WELL TESTS:  
Drawdown ft. after hours G.P.M.  
Drawdown ft. after hours G.P.M.

USE OF WATER irrigation 29.1 acres Temp. °F. 19  
SOURCE OF INFORMATION GR-641

DRILLER or DIGGER  
ADDITIONAL DATA:  
Log Water Level Measurements Chemical Analysis Aquifer Test

REMARKS: