

STATE ENGINEER
Salem, Oregon

LANE
6463

Well Record

STATE WELL NO. 15/4W-34 D(1)
COUNTY Lane
APPLICATION NO. GR-1117

GR- 1077

OWNER: Thorvald C. Andersen


MAILING ADDRESS: 590 Willamette Drive

LOCATION OF WELL: Owner's No.

CITY AND STATE: Junction City, Oregon

NW 1/4 NW 1/4 Sec. 34 T. 15 S., R. 4 W., W.M.

Bearing and distance from section or subdivision corner 5303.64' N. 5°07'E. of SW cor. Sec. 34.

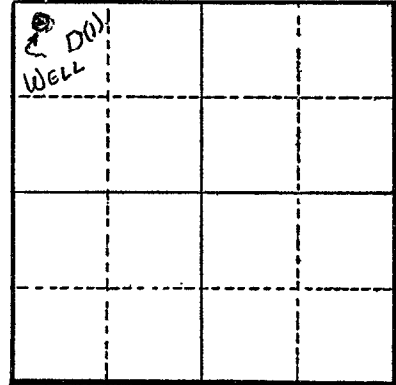

Section 34

Altitude at well 318 ft.

TYPE OF WELL: Driven Date Constructed 1947

Depth drilled 22 ft. Depth cased 22 ft.

CASING RECORD:

3 inch

FINISH:

Perforated from 19 to 22 ft.

AQUIFERS:

WATER LEVEL:

8 ft.

PUMPING EQUIPMENT: Type A. C. Cent. H.P. 15

Capacity 375 G.P.M.

WELL TESTS:

Drawdown ft. after hours G.P.M.

Drawdown ft. after hours G.P.M.

USE OF WATER Irrigation Temp. °F., 19

SOURCE OF INFORMATION G. R. Record

DRILLER or DIGGER

ADDITIONAL DATA:

Log N.A. Water Level Measurements Chemical Analysis Aquifer Test

REMARKS:

Irrigation of 57.58 acres.