

STATE ENGINEER
Salem, Oregon

LANE
6464

Well Record

STATE WELL NO. ...15/4W-34D(2)
COUNTY ...Lane
APPLICATION NO. ...GR...1119

GR- 1079

OWNER: ...Thorvald G. Andersen

MAILING ADDRESS: ...590 Willamette Drive


LOCATION OF WELL: Owner's No.

CITY AND STATE: ...Junction City, Oregon

...NW 1/4 NW 1/4 Sec. ...34 T. ...15 S., R. ...4 W., W.M.

Bearing and distance from section or subdivision

corner ...4365.08' N10°38'10"E. of SW cor. Sec. ...34.

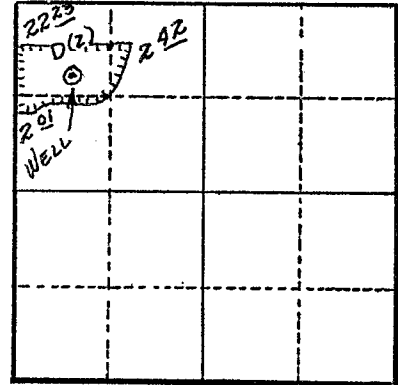

Section ...34

Altitude at well ...375 ft.

TYPE OF WELL: ...Driven Date Constructed ...1940

Depth drilled ...22 ft. Depth cased ...22 ft.

CASING RECORD:

2 - 3 inch

FINISH:

Perforated from 19 to 22 ft.

AQUIFERS:

WATER LEVEL:

8 ft.

PUMPING EQUIPMENT: Type ...A. C. Cent. H.P. ...15
Capacity ...375 G.P.M.

WELL TESTS:

Drawdown ft. after hours G.P.M.

Drawdown ft. after hours G.P.M.

USE OF WATER ...Irrigation Temp. ...°F., 19

SOURCE OF INFORMATION ...G. R. Record

DRILLER or DIGGER

ADDITIONAL DATA:

Log ...N.A. Water Level Measurements Chemical Analysis Aquifer Test

REMARKS:

Irrigation of 26.66 acres.