

STATE ENGINEER
Salem, Oregon

LANE
6465

Well Record

STATE WELL NO. 15/LW-34M(1)
COUNTY Lane
APPLICATION NO. GR-319

OWNER: Merle Hentze


MAILING ADDRESS: Rt. 2

LOCATION OF WELL: Owner's No. 2

CITY AND STATE: Junction City, Oregon

NW 1/4 SW 1/4 Sec. 34 T. 15 S., R. 4 W., W.M.

Bearing and distance from section or subdivision corner 1683 ft. N. 21° E. from SE cor. Sec. 33

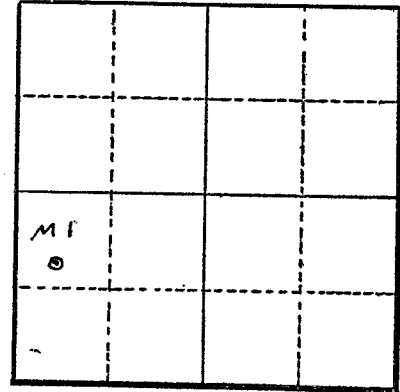

Section 34

Altitude at well Interpolated

TYPE OF WELL: driven Date Constructed 5/16/47

Depth drilled 20 Depth cased 20

CASING RECORD: 4 inch black iron casing set from 0 to 20 ft.

FINISH: 8 - 3/4 inch holes from 17 ft. to 20 ft.

AQUIFERS: unknown

WATER LEVEL: 10 ft. below land surface

PUMPING EQUIPMENT: Type Jacuzzi centrifugal H.P. 7 1/2
Capacity 250 G.P.M.

WELL TESTS:

Drawdown -- ft. after hours pumping 216 G.P.M.
Drawdown -- ft. after hours G.P.M.

USE OF WATER irrigation 22.83 acres Temp. °F. 19
SOURCE OF INFORMATION Reg. Statement GR-319

DRILLER or DIGGER

ADDITIONAL DATA:

Log no. Water Level Measurements Chemical Analysis Aquifer Test

REMARKS: