

STATE ENGINEER  
Salem, Oregon

**LANE**  
6466

# Well Record

STATE WELL NO. 15/4W-34M  
COUNTY Lane  
APPLICATION NO. GR-910

OWNER: Brockner Mikkelsen

MAILING  
ADDRESS:  
CITY AND  
STATE:

174 Willamette Dr.

Junction City, Oregon


LOCATION OF WELL: Owner's No. \_\_\_\_\_

NW  $\frac{1}{4}$  SW  $\frac{1}{4}$  Sec. 34 T. 15 S., R. 4 W., W.M.

Bearing and distance from section or subdivision

corner 2002.67 ft. N. 15° 25' 10" E. of SW

cor. Sec. 34

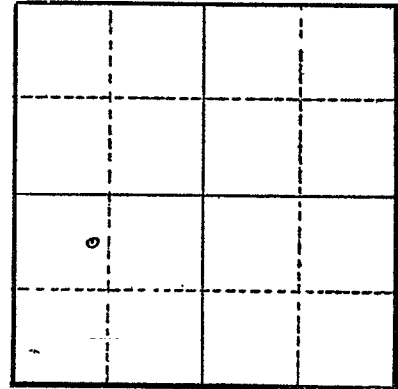

Section 34

Altitude at well 322

TYPE OF WELL: driven Date Constructed May 1948

Depth drilled 30 Depth cased 30

CASING RECORD: 4 inch steel 0 ft. - 30 ft.

FINISH: Perforated 27 ft. - 30 ft.

AQUIFERS: Sand & gravel

WATER LEVEL: 8 ft.

PUMPING EQUIPMENT: Type Fairbanks Morse centrifugal H.P. 10 elec.  
Capacity 300 G.P.M.

WELL TESTS: No Test  
Drawdown \_\_\_\_\_ ft. after \_\_\_\_\_ hours \_\_\_\_\_ G.P.M.  
Drawdown \_\_\_\_\_ ft. after \_\_\_\_\_ hours \_\_\_\_\_ G.P.M.

USE OF WATER irrigation Temp. \_\_\_\_\_ °F. \_\_\_\_\_, 19\_\_\_\_\_

SOURCE OF INFORMATION owner

DRILLER or DIGGER \_\_\_\_\_

ADDITIONAL DATA:

Log X Water Level Measurements \_\_\_\_\_ Chemical Analysis \_\_\_\_\_ Aquifer Test \_\_\_\_\_

REMARKS: Log: Sand & gravel 0 ft. - 30 ft.