

OWNER: Merle Hentze


MAILING ADDRESS: Rt. 2

LOCATION OF WELL: Owner's No. 3

CITY AND STATE: Junction City, Oregon

NW 1/4 SW 1/4 Sec. 34 T. 15 S., R. 4 W., W.M.

Bearing and distance from section or subdivision corner 2095.5 ft. N. 39° E. from SE cor. Sec. 33

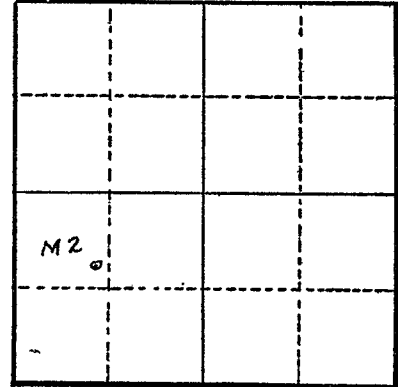

Altitude at well interpolated

Section 34

TYPE OF WELL: driven Date Constructed 7/1/53

Depth drilled 34 Depth cased 34

CASING RECORD: 4 inch black iron casing set from 0 to 34 ft.

FINISH: 8 - 1/4" x 3" slots set from 31 to 34 ft.

AQUIFERS: unknown

WATER LEVEL: 12 ft. below land surface

PUMPING EQUIPMENT: Type Jacuzzi 4" centrifugal H.P. 7 1/2
Capacity 250 G.P.M.

WELL TESTS:

Drawdown --- ft. after --- hours pumping 216 G.P.M.

Drawdown --- ft. after --- hours --- G.P.M.

USE OF WATER irrigation 22.83 acres Temp. --- °F., 19

SOURCE OF INFORMATION Reg. Statement GR-319

DRILLER or DIGGER

ADDITIONAL DATA:

Log No Water Level Measurements --- Chemical Analysis --- Aquifer Test ---

REMARKS: