

STATE ENGINEER
Salem, Oregon

LANE
6468

Well Record

STATE WELL NO. 15/4W-34P
COUNTY LANE
APPLICATION NO. GR-2438

OWNER: Arnold Bodtker

MAILING ADDRESS:

LOCATION OF WELL: Owner's No.


CITY AND STATE:

Junction City, Oregon

SE 1/4 SW 1/4 Sec. 34 T. 15 S., R. 4 W., W.M.

Bearing and distance from section or subdivision

corner 1682.66' N. 57° 27' 30" E.

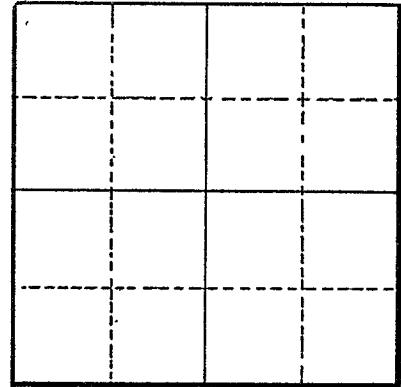

Altitude at well

TYPE OF WELL: Driven Date Constructed 1948

Depth drilled 22 Depth cased

Section

CASING RECORD:

FINISH:

3 slots per foot from 16 to 22

AQUIFERS:

WATER LEVEL:

PUMPING EQUIPMENT: Type Cornell H.P. 10
Capacity G.P.M.

WELL TESTS:

Drawdown ft. after hours G.P.M.

Drawdown ft. after hours G.P.M.

USE OF WATER Irrigation Temp. °F. 19

SOURCE OF INFORMATION GR-2411

DRILLER or DIGGER

ADDITIONAL DATA:

Log Water Level Measurements Chemical Analysis Aquifer Test

REMARKS: