

LANE
6538

Well Record

OWNER: Howard Gibson and Gladys Gibson


MAILING ADDRESS: Route 3.

LOCATION OF WELL: Owner's No.

CITY AND STATE: Junction City, Oregon

1/4 1/4 Sec. 12 T. 15 S., R. 5 W., W.M.

Bearing and distance from section or subdivision corner 990' W. and 675' S.

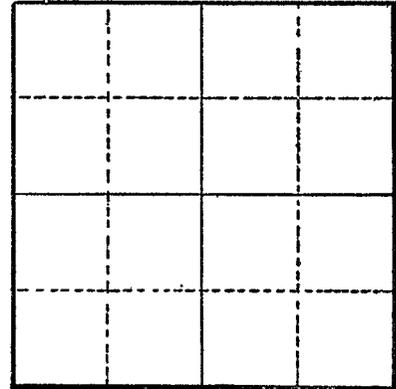

Section

Altitude at well

TYPE OF WELL: Drilled Date Constructed 1952

Depth drilled 45 Depth cased 45

CASING RECORD:

12-inch

FINISH:

Perforations approximately 4 per foot from 10' to 45' size approximately 3/8" to 6"

AQUIFERS:

Loam and gravel with thin layers of sand

WATER LEVEL:

9-feet

PUMPING EQUIPMENT: Type Jacuzzi Turbine H.P. 15

Capacity 250 G.P.M.

WELL TESTS:

Drawdown 3 ft. after hours Pumping 250 G.P.M.

Drawdown ft. after hours G.P.M.

USE OF WATER Irrigation Temp. °F. 19

SOURCE OF INFORMATION GR-2290

DRILLER or DIGGER

ADDITIONAL DATA:

Log Water Level Measurements Chemical Analysis Aquifer Test

REMARKS:

Loam 6' 6'
Gravel with thin layers of sand 39' 45'



Oregon Water Resources Department
 725 Summer Street NE, Suite A
 Salem Oregon 97301
 (503) 986-0900
 www.oregon.gov/owrd

Application for Well ID Number

RECEIVED

FEB 6 2026

OWRD

Do not complete if the well already has a Well Identification Number.

I. OWNER INFORMATION

Current Owner Name (please print): Lochmead Farms
 Mailing Address: 125 East 6th Ave
 City, State, Zip: Junction City, Oregon, 97448
 Mail Well ID to: SAME AS ABOVE In Care Of (C/O)
 Name & Address: _____
 City, State, Zip: _____

II. WELL LOCATION INFORMATION (Please fill out as completely as possible)

Township: 15 S (North / South) Range: 5 W (East / West) Section: 12 NE 1/4 of the SW 1/4
 Tax Lot (usually last 3-5 numbers of Tax Map #): 900 County Lane
 GPS Coordinates: 44.27842 N -123.24373 W
 Street Address of Well, City: 96428 Hwy 99W Junction City OR, 97448
 If the property had a different street address in the past: _____

III. GENERAL WELL INFORMATION (Please fill out as completely as possible, AND attach copy of Well Report, if available)

Use of Well (domestic, irrigation, commercial, industrial, monitoring): Commercial
 Date Well Constructed (or property built): 1952 Total Well Depth: 45 ft Casing Diameter: 12 in
 Owner at time the well was constructed (if known): Howard & Gladys Gibson Well Report # (if known): LANE 6538
 Other Information: Groundwater Registration GR 2409 North well location

SUBMITTED BY (please print): Chris Gibson
 PHONE: 541-510-4695 EMAIL &/or FAX: Lochmeadfarms@aol.com

To send the completed application, you may MAIL it to: Oregon Water Resources Dept. 725 Summer St NE, Suite A, Salem, Oregon 97301.
 Or EMAIL the completed PDF form to: Ladeena.K.Ashley@water.oregon.gov, or FAX it to: (503) 986-0902.

For Official Use Only by the Oregon Water Resources Department:

Received Date:
2-6-2026

Well Report Number:
LANE 6538

Well Identification #:
L-160025