

LANE
6538


Well Record

OWNER: Howard Gibson and Gladys Gibson MAILING ADDRESS: Route 3,

LOCATION OF WELL: Owner's No. CITY AND STATE: Junction City, Oregon

1/4 1/4 Sec. 12 T. 15 S., R. 5 W., W.M.

Bearing and distance from section or subdivision corner 990' W. and 675' S.

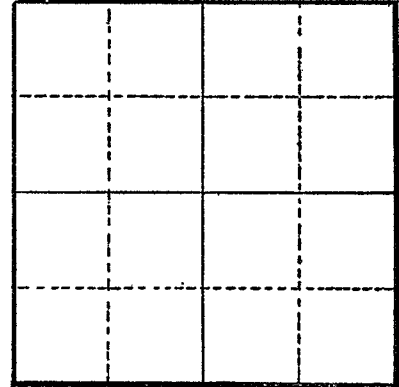

Section

Altitude at well

TYPE OF WELL: Drilled Date Constructed 1952

Depth drilled 45 Depth cased 45

CASING RECORD:

12-inch

FINISH:

Perforations approximately 4 per foot from 10' to 45' size approximately 3/8" to 6"

AQUIFERS:

Loam and gravel with thin layers of sand

WATER LEVEL:

9-feet

PUMPING EQUIPMENT: Type Jacuzzi Turbine H.P. 15
Capacity 250 G.P.M.

WELL TESTS:

Drawdown 3 ft. after hours Pumping 250 G.P.M.

Drawdown ft. after hours G.P.M.

USE OF WATER Irrigation Temp. °F. 19

SOURCE OF INFORMATION GR-2290

DRILLER or DIGGER

ADDITIONAL DATA:

Log Water Level Measurements Chemical Analysis Aquifer Test

REMARKS:

Loam 6' 6'
Gravel with thin layers of sand 39' 45'