

LANE
6541


Well Record

OWNER: Howard Gibson and Gladys Gibson MAILING ADDRESS: Route 3

LOCATION OF WELL: Owner's No. #1 CITY AND STATE: Junction City, Oregon

NE $\frac{1}{4}$ SW $\frac{1}{4}$ Sec. 12 T. 15 N S., R. 5 W, W.M.

Bearing and distance from section or subdivision corner 990' W. and 1000' S.

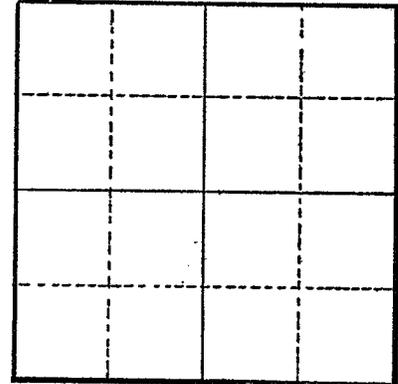

Section _____

Altitude at well _____

TYPE OF WELL: Drilled Date Constructed 1951

Depth drilled 70 Depth cased 70

CASING RECORD:

- 12-inch
- 8-inch

FINISH:

Perforations approximately 6 per foot from 10' to 40' size approximately $\frac{1}{4}$ " x 4"

AQUIFERS:

Loam, gravel, sand and clay

WATER LEVEL:

9-feet

PUMPING EQUIPMENT: Type Jacuzzi Turbine H.P. 15
Capacity 270 G.P.M.

WELL TESTS:

Drawdown 3 ft. after _____ hours Pumping 250 G.P.M.
Drawdown _____ ft. after _____ hours _____ G.P.M.

USE OF WATER Irrigation Temp. _____ °F., 19

SOURCE OF INFORMATION GR-2289

DRILLER or DIGGER _____

ADDITIONAL DATA:

Log Water Level Measurements _____ Chemical Analysis _____ Aquifer Test _____

REMARKS:

- Loam 6 6
- Gravel and sand 6 12
- Boulders and gravel 4 16
- Coarse gravel 8 24
- Small gravel and sand 8 32
- Coarse gravel 13 45
- Blue clay 13 58
- Gravel and sand 4 62
- Grey clay 8 70

Water bearing stratas--21' - 40' - 58' - 62'



Oregon Water Resources Department
 725 Summer Street NE, Suite A
 Salem Oregon 97301
 (503) 986-0900
 www.oregon.gov/owrd

Application for Well ID Number

RECEIVED

FEB 6 2026

OWRD

Do not complete if the well already has a Well Identification Number.

I. OWNER INFORMATION

Current Owner Name (please print): Lochmead Farms
 Mailing Address: 125 East 6th Ave
 City, State, Zip: Junction City, Oregon, 97448
 Mail Well ID to: SAME AS ABOVE In Care Of (C/O)
 Name & Address: _____
 City, State, Zip: _____

II. WELL LOCATION INFORMATION (Please fill out as completely as possible)

Township: 15 S (North / South) Range: 5 W (East / West) Section: 12 NE 1/4 of the SW 1/4
 Tax Lot (usually last 3-5 numbers of Tax Map #): 900 County Lane
 GPS Coordinates: 44.27771 N -123.24385 W
 Street Address of Well, City: 96428 Hwy 99W Junction City OR, 97448
 If the property had a different street address in the past: _____

III. GENERAL WELL INFORMATION (Please fill out as completely as possible, AND attach copy of Well Report, if available)

Use of Well (domestic, irrigation, commercial, industrial, monitoring): Commercial
 Date Well Constructed (or property built): 1951 Total Well Depth: 70 ft Casing Diameter: 12 in
 Owner at time the well was constructed (if known): Howard & Gladys Gibson Well Report # (if known): LANE 6541
 Other Information: Groundwater Registration GR 2408 South well location

SUBMITTED BY (please print): Chris Gibson
 PHONE: 541-510-4695 EMAIL &/or FAX: Lochmeadfarms@aol.com

To send the completed application, you may MAIL it to: Oregon Water Resources Dept. 725 Summer St NE, Suite A, Salem, Oregon 97301.
 Or EMAIL the completed PDF form to: Ladeena.K.Ashley@water.oregon.gov, or FAX it to: (503) 986-0902.

For Official Use Only by the Oregon Water Resources Department:

Received Date:
2-6-2026

Well Report Number:
LANE 6541

Well Identification #:
L-160026