

LANE
6541


Well Record

OWNER: Howard Gibson and Gladys Gibson MAILING ADDRESS: Route 3

LOCATION OF WELL: Owner's No. #1 CITY AND STATE: Junction City, Oregon

NE $\frac{1}{4}$ SW $\frac{1}{4}$ Sec. 12 T. 15 N S., R. 5 W, W.M.

Bearing and distance from section or subdivision corner 990' W. and 1000' S.

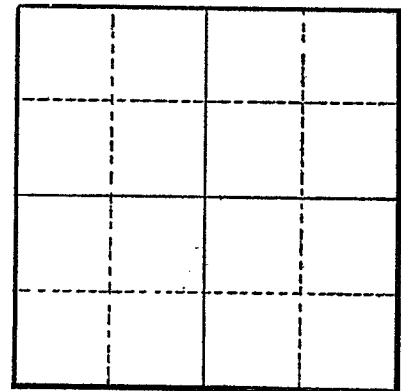

Section _____

Altitude at well _____

TYPE OF WELL: Drilled Date Constructed 1951

Depth drilled 70 Depth cased 70

CASING RECORD:

- 12-inch
- 8-inch

FINISH:

Perforations approximately 6 per foot from 10' to 40' size approximately $\frac{1}{4}$ " x 4"

AQUIFERS:

Loam, gravel, sand and clay

WATER LEVEL:

9-feet

PUMPING EQUIPMENT: Type Jacuzzi Turbine H.P. 15
Capacity 270 G.P.M.

WELL TESTS:

Drawdown 3 ft. after _____ hours Pumping 250 G.P.M.

Drawdown _____ ft. after _____ hours _____ G.P.M.

USE OF WATER Irrigation Temp. _____ °F., 19

SOURCE OF INFORMATION GR-2289

DRILLER or DIGGER _____

ADDITIONAL DATA:

Log Water Level Measurements _____ Chemical Analysis _____ Aquifer Test _____

REMARKS:

- Loam 6 6
- Gravel and sand 6 12
- Boulders and gravel 4 16
- Coarse gravel 8 24
- Small gravel and sand 8 32
- Coarse gravel 13 45
- Blue clay 13 58
- Gravel and sand 4 62
- Grey clay 8 70

Water bearing stratas--21' - 40' - 58' - 62'