

STATE ENGINEER
Salem, Oregon

LANE
6618

Well Record

GR- 1344

STATE WELL NO. 15/5W-23A
COUNTY Lane
APPLICATION NO. GR- 1387

OWNER: Elbert R. Starns

MAILING

ADDRESS:

Star Rt. M.

LOCATION OF WELL: Owner's No.

CITY AND


STATE:

Junction City, Oregon

NE 1/4 NE 1/4 Sec. 23 T. 15 S., R. 5 W., W.M.

Bearing and distance from section or subdivision

corner 778' S. & 220' W. from NE cor. Sec. 23.

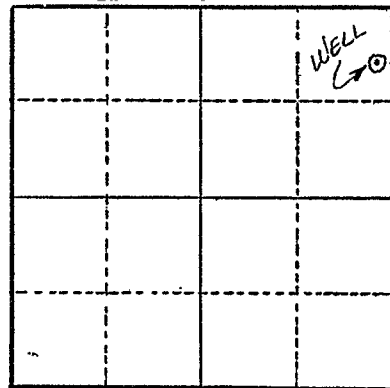

Altitude at well

TYPE OF WELL: Driven Date Constructed 1943

Depth drilled 20 ft. Depth cased 20 ft.

Section 23

CASING RECORD:

2 inch

FINISH:

Perforated

AQUIFERS:

WATER LEVEL:

6 ft.

PUMPING EQUIPMENT: Type Cornell 1 1/2 in. Cent. H.P. 2
Capacity G.P.M.

WELL TESTS:

Drawdown 12 ft. after hours 40 G.P.M.

Drawdown 16 ft. after hours 60 G.P.M.

USE OF WATER Irrigation Temp. °F. 19

SOURCE OF INFORMATION G. R. Record

DRILLER or DIGGER

ADDITIONAL DATA:

Log N.A. Water Level Measurements Chemical Analysis Aquifer Test

REMARKS:

Irrigation of 15 acres.