

STATE ENGINEER
Salem, Oregon

LANE
6623

Well Record

STATE WELL NO. 15/5W-24F
COUNTY LANE
APPLICATION NO. GR-2931

OWNER: LeVerne W. Stevens

MAILING

ADDRESS: 955 Ferguson Road

LOCATION OF WELL: Owner's No.

CITY AND

STATE: Junction City, Oregon

SE $\frac{1}{4}$ NW $\frac{1}{4}$ Sec. 24 T. 15 N. S. R. 5 E. W.M.


Bearing and distance from section or subdivision

corner 2310' S. and 2145' E.

Altitude at well

TYPE OF WELL: drove Date Constructed 1950

Depth drilled 18 Depth cased 18

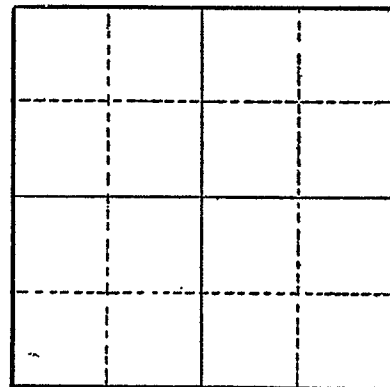

Section

CASING RECORD:

4-inch

FINISH:

Slotted from 15 to 18

AQUIFERS:

WATER LEVEL:

12-feet

PUMPING EQUIPMENT: Type Cornell Centrifugal H.P. 5
Capacity 140 G.P.M.

WELL TESTS:

Drawdown ft. after hours G.P.M.

Drawdown ft. after hours G.P.M.

USE OF WATER irrigation Temp. °F. 19

SOURCE OF INFORMATION GR-2757

DRILLER or DIGGER Walter Nelson, Junction City, Oregon

ADDITIONAL DATA:

Log Water Level Measurements Chemical Analysis Aquifer Test

REMARKS: