

STATE OF OREGON
WATER SUPPLY WELL REPORT
(as required by ORS 537.765)

(WELL I.D.)# L 82099
 (START CARD) # 187148

Instructions for completing this report are on the last page of this form.

(1) OWNER: McDougal Brothers Well Number _____

Name McDougal Brothers
 Address P.O. Box 518
 City Creswell State OR Zip 97426

(2) TYPE OF WORK
 New Well Deepening Alteration (repair/recondition) Abandonment

(3) DRILL METHOD:
 Rotary Air Rotary Mud Cable Auger
 Other

(4) PROPOSED USE:
 Domestic Community Industrial Irrigation
 Thermal Injection Livestock Other

(5) BORE HOLE CONSTRUCTION:
 Special Construction approval Yes No Depth of Completed Well 300 ft.
 Explosives used Yes No Type _____ Amount _____

HOLE			SEAL				
Diameter	From	To	Material	From	To	Sacks or pounds	
10	0	18	Cement	0	18	6 Sacks	
8	18	38	Cement	32	38	2 Sacks	
6	38	300					

How was seal placed: Method A B C D E
 Other poured
 Backfill placed from _____ ft. to _____ ft. Material _____
 Gravel placed from _____ ft. to _____ ft. Size of gravel _____

(6) CASING/LINER:

	Diameter	From	To	Gauge	Steel	Plastic	Welded	Threaded
Casing	6	+2	38	250	<input checked="" type="checkbox"/>	<input type="checkbox"/>	<input checked="" type="checkbox"/>	<input type="checkbox"/>
Liner	4	0	300	sdr26	<input type="checkbox"/>	<input checked="" type="checkbox"/>	<input checked="" type="checkbox"/>	<input type="checkbox"/>

Final location of shoe(s) _____

(7) PERFORATIONS/SCREENS:

Perforations Method saw
 Screens Type _____ Material _____

From	To	Slot size	Number	Diameter	Tele/pipe size	Casing	Liner
100	300	1/8	200	4	sdr26	<input type="checkbox"/>	<input checked="" type="checkbox"/>

(8) WELL TESTS: Minimum testing time is 1 hour

Yield gal/min	Drawdown	Drill stem at	Time
50+	total	300	1 hr.

Temperature of water 56 Depth Artesian Flow Found _____
 Was a water analysis done? Yes By whom _____
 Did any strata contain water not suitable for intended use? Too little
 Salty Muddy Odor Colored Other _____
 Depth of strata: _____

(9) LOCATION OF WELL by legal description:
 County Lane Latitude 43.58.571 Longitude 122.52.629
 Township 18 S Range 02 W WM
 Section 25 1/4 1/4
 Tax Lot 300 Lot _____ Block _____ Subdivision _____
 Street Address of Well (or nearest address) 37460 Jasper Lowell Road


(10) STATIC WATER LEVEL:
25 ft. below land surface. Date 8-1-06
 Artesian pressure _____ lb. per square inch. Date _____

(11) WATER BEARING ZONES:
 Depth at which water was first found 218

From	To	Estimated Flow Rate	SWL
218	220	50+	25

(12) WELL LOG:
 Ground Elevation _____

Material	From	To	SWL
Top soil	0	6	
Sand and gravel	6	32	25
Blue Gray Sandstone	32	300	

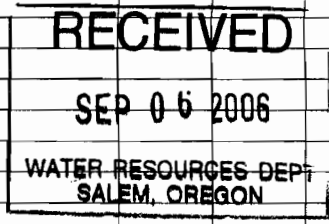

Date started 8-1-06 Completed 8-1-06

(unbonded) Water Well Constructor Certification:
 I certify that the work I performed on the construction, alteration, or abandonment of this well is in compliance with Oregon water supply well construction standards. Materials used and information reported above are true to the best of my knowledge and belief.

Signed Terry Queen WWC Number 1800 Date 8-3-06

(bonded) Water Well Constructor Certification:
 I accept responsibility for the construction, alteration, or abandonment work performed on this well during the construction dates reported above. All work performed during this time is in compliance with Oregon water supply well construction standards. This report is true to the best of my knowledge and belief.

Signed _____ WWC Number 1553 Date 8-3-06