

STATE ENGINEER
Salem, Oregon

~~LANE 66767~~
~~LANE~~ Well Record
~~10532~~ GR- 1368


STATE WELL NO. 17/2W-19E
COUNTY Lane
APPLICATION NO. GR- 1414
LANE 00767

OWNER: Nellie M. Scott
MAILING ADDRESS: Rt. 1, Box 37

LOCATION OF WELL: Owner's No. #1
CITY AND STATE: Springfield, Oregon

SW 1/4 NW 1/4 Sec. 19 T. 17 S., R. 2 W., W.M.

Bearing and distance from section or subdivision
corner 1050' S., & 700' E. from NW cor. D.L.C. #52

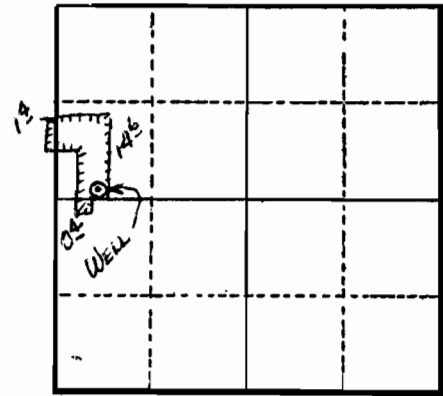

Altitude at well

TYPE OF WELL: Dug Date Constructed 1920

Depth drilled 21' Depth cased 21'

Section 19

CASING RECORD:

24" welded water tanks

FINISH:

AQUIFERS:

WATER LEVEL:

16'

PUMPING EQUIPMENT: Type Deming 3" Cent. H.P. 7 1/2

Capacity 250 G.P.M.

WELL TESTS:

Drawdown ft. after hours G.P.M.

Drawdown ft. after hours G.P.M.

USE OF WATER Irrigation Temp. °F., 19

SOURCE OF INFORMATION G. R. Record

DRILLER or DIGGER

ADDITIONAL DATA:

Log N.A. Water Level Measurements Chemical Analysis Aquifer Test

REMARKS:

Irrigation of 16.4 acres