

STATE ENGINEER
Salem, Oregon

~~LANE~~ 66768
Well Record
10333 GR- 1346

STATE WELL NO. 17/2W-19E
COUNTY Lane
APPLICATION NO. GR- 1389

OWNER: Robert W. Bennett

MAILING ADDRESS:

LANE 66768
Rt. 1, Box 45

LOCATION OF WELL: Owner's No.


CITY AND STATE:

Springfield, Oregon

SW 1/4 NW 1/4 Sec. 19 T. 17 S. R. 2 W., W.M.

Bearing and distance from section or subdivision

corner S. 24° E. 2800' from NW cor. Sec. 19

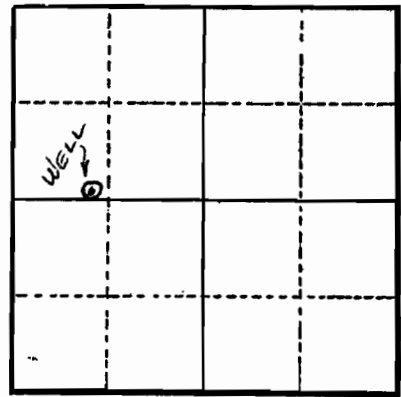

Section 19

Altitude at well 465 ft.

TYPE OF WELL: Dug Date Constructed 1943

Depth drilled 20 ft. Depth cased 20 ft.

CASING RECORD:

30 in. Concrete

FINISH:

AQUIFERS:

WATER LEVEL:

6 ft.

PUMPING EQUIPMENT: Type Pacific 1 1/2 in. Cent. H.P. 5

Capacity 225 G.P.M.

WELL TESTS:

Drawdown 0.5 ft. after hours 200 G.P.M.

Drawdown ft. after hours G.P.M.

USE OF WATER Irrigation Temp. °F., 19

SOURCE OF INFORMATION G. R. Record

DRILLER or DIGGER

ADDITIONAL DATA:

Log N.A. Water Level Measurements Chemical Analysis Aquifer Test

REMARKS:

Irrigation of 13 acres