

STATE ENGINEER
Salem, Oregon


~~LANE~~ 66777
~~1935~~
Well Record

LANE
STATE WELL NO. 17/2W-19F
COUNTY LANE
~~APPLICATION NO. GR-2381~~

OWNER: Sam's Garden
MAILING ADDRESS: Rt. 1, Box 63

LOCATION OF WELL: Owner's No.
CITY AND STATE: Springfield, Oregon

SE 1/4 NW 1/4 Sec. 19 T. 12 S., R. 2 W., W.M.
Bearing and distance from section or subdivision
corner 2275' N. 86° 15' E. of the NW cor. of the
Felix Scott Sr., D.L.C.

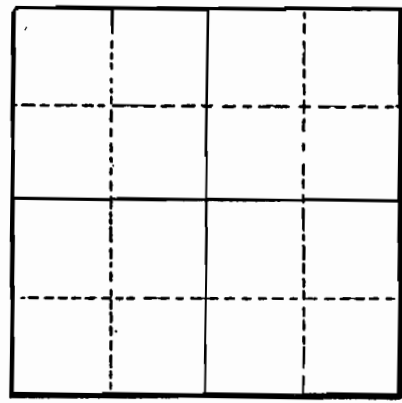

Section

Altitude at well

TYPE OF WELL: Dug Date Constructed 1941

Depth drilled 10 Depth cased 10

CASING RECORD:

48-inch

FINISH:

AQUIFERS:
Loam, Sand & Gravel

WATER LEVEL:
4-feet

PUMPING EQUIPMENT: Type FM & Co. Cent. 3" H.P. 20
Capacity 300 G.P.M.

WELL TESTS:
Drawdown ft. after hours G.P.M.
Drawdown ft. after hours G.P.M.

USE OF WATER Irrigation Temp. °F., 19

SOURCE OF INFORMATION GR-2263

DRILLER or DIGGER

ADDITIONAL DATA:
Log Water Level Measurements Chemical Analysis Aquifer Test

REMARKS:

Loam 7' 3'
Sand and Gravel 3' 0'