

STATE ENGINEER  
Salem, Oregon

LANE 66788

~~LANE~~ Well Record ~~LANE~~  
10536 66788

STATE WELL NO. 17/2W-19H  
COUNTY Lane  
APPLICATION NO. GR-4181

OWNER: Paul E. Coldiron


MAILING ADDRESS: RR 1 Box 74

LOCATION OF WELL: Owner's No.

CITY AND STATE: Springfield, Oregon

SE 1/4 NE 1/4 Sec. 19 T. 17 N. S., R. 2 E. W., W.M.

Bearing and distance from section or subdivision  
corner 3040' N 25° W from SE corner Section 19

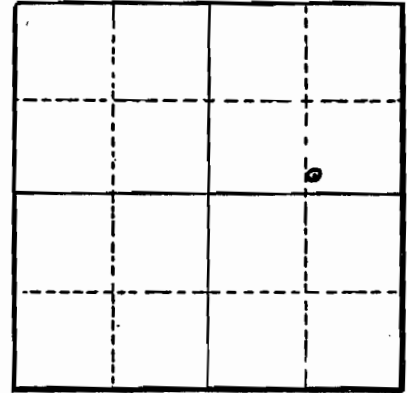

Section 19

Altitude at well

TYPE OF WELL: Dug Date Constructed 1935

Depth drilled 15 Depth cased

CASING RECORD:

Cribbed Well

FINISH:

AQUIFERS:

Top soil  
Sand  
River Gravel

WATER LEVEL:

PUMPING EQUIPMENT: Type Cornel EW H.P. 7 1/2  
Capacity 200 G.P.M.

WELL TESTS:

Drawdown 2 ft. after 200 hours G.P.M.

Drawdown ft. after hours G.P.M.

USE OF WATER Irrigation Temp. °F., 19

SOURCE OF INFORMATION GR-3832

DRILLER or DIGGER NA

ADDITIONAL DATA:

Log X Water Level Measurements Chemical Analysis Aquifer Test

REMARKS: Topsoil 6'  
sand 2'  
River Gravel 7'

Flow from River