

STATE ENGINEER  
Salem, Oregon

~~LANE~~ 66875  
**Well Record**

STATE WELL NO. 17/2W-19M  
COUNTY LANE  
APPLICATION NO. GR-3410

OWNER: Merwyn J. Thompson


MAILING ADDRESS: Rt 1, Box 40

LOCATION OF WELL: Owner's No. \_\_\_\_\_

CITY AND STATE: Springfield, Ore

NW 1/4 SW 1/4 Sec. 19 T. 17 S., R. 2 W., W.M.

Bearing and distance from section or subdivision  
corner 315' N from SE Cor. on E. line of property

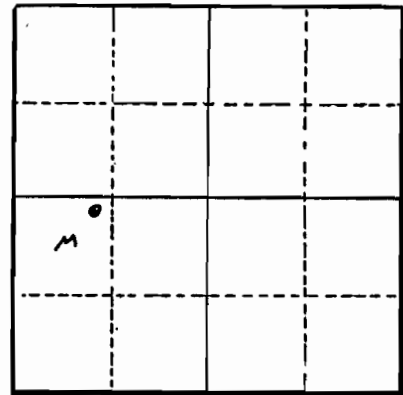

Section 19

Altitude at well \_\_\_\_\_

TYPE OF WELL: Dug Date Constructed 1939

Depth drilled 14 1/2' Depth cased \_\_\_\_\_

CASING RECORD:

FINISH:

AQUIFERS:

WATER LEVEL: 8'

PUMPING EQUIPMENT: Type Fairbanks Morse H.P. 5  
Capacity 90 G.P.M.

WELL TESTS:  
Drawdown 3 ft. after \_\_\_\_\_ hours 90 G.P.M.  
Drawdown 6 ft. after \_\_\_\_\_ hours 90 G.P.M.

USE OF WATER Irrigation Temp. \_\_\_\_\_ °F., 19

SOURCE OF INFORMATION GR-3934

DRILLER or DIGGER \_\_\_\_\_

ADDITIONAL DATA:  
Log NA Water Level Measurements \_\_\_\_\_ Chemical Analysis \_\_\_\_\_ Aquifer Test \_\_\_\_\_

REMARKS: