

STATE ENGINEER  
Salem, Oregon

~~LANE~~ 66876  
Well Record

STATE WELL NO. 17/2W-19M  
COUNTY LANE  
APPLICATION NO. GR-2324

OWNER: Glen F. or Gertrude Shaw


MAILING ADDRESS: Rt. 1, Box 36

LOCATION OF WELL: Owner's No.

CITY AND STATE: Springfield, Oregon

NW 1/4 SW 1/4 Sec. 19 T. 17 N. S. R. 2 W., W.M.

Bearing and distance from section or subdivision corner N. 4° 05' W. 3025' to NW corner of Section 19

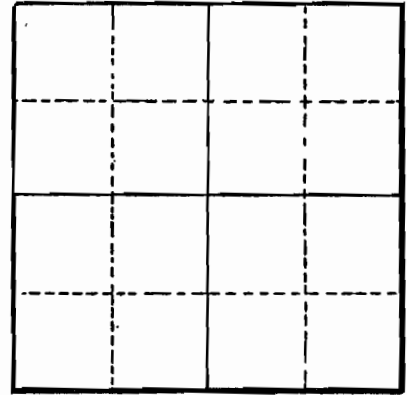

Section

Altitude at well

TYPE OF WELL: Drove Date Constructed 1949

Depth drilled 26 1/2 Depth cased 26 1/2

CASING RECORD:

2-inch  
3-inch

FINISH:

Holes drilled from 24 to 26 1/2  
from 24 to 27

AQUIFERS:

Loam, rock and gravel

WATER LEVEL:

8-feet

PUMPING EQUIPMENT: Type Allis Chalmer Centrifugal H.P. 5  
Capacity 42 G.P.M.

WELL TESTS:

Drawdown ft. after hours G.P.M.  
Drawdown ft. after hours G.P.M.

USE OF WATER For Pasture Temp. °F., 19

SOURCE OF INFORMATION GR-2212

DRILLER or DIGGER D. D. Dickerson, 1280 River Road

ADDITIONAL DATA:

Log X Water Level Measurements Chemical Analysis Aquifer Test

REMARKS:

There are 10" loam and 16feet rock and gravel