

STATE ENGINEER  
Salem, Oregon

~~LANE~~ **LANE 66877**  
**Well Record**

STATE WELL NO. 17/2W-19N  
COUNTY LANE  
APPLICATION NO. GR-2585

OWNER: Evert A. Snyder


MAILING ADDRESS: Rt 1 Box 52,

LOCATION OF WELL: Owner's No. \_\_\_\_\_

CITY AND STATE: Springfield, Oregon

S<sup>1</sup>/<sub>4</sub> S<sup>1</sup>/<sub>4</sub> Sec. 19 T. 17 S., R. 2 W., W.M.

Bearing and distance from section or subdivision  
corner About 75' S of N property line & 3' from  
E property line

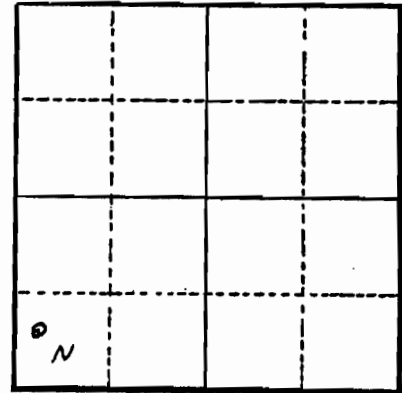

Section 19

Altitude at well \_\_\_\_\_

TYPE OF WELL: Driven pipe Date Constructed 1950

Depth drilled 20' Depth cased \_\_\_\_\_

CASING RECORD:

FINISH:

AQUIFERS:

WATER LEVEL:

NA

PUMPING EQUIPMENT: Type Sears, Momart, jet H.P. 1/2  
Capacity 8 - 10 G.P.M.

WELL TESTS:

Drawdown \_\_\_\_\_ ft. after \_\_\_\_\_ hours 25 G.P.M.

Drawdown \_\_\_\_\_ ft. after \_\_\_\_\_ hours \_\_\_\_\_ G.P.M.

USE OF WATER Irrigation Temp. \_\_\_\_\_ °F. \_\_\_\_\_, 19\_\_\_\_\_

SOURCE OF INFORMATION GR-3890

DRILLER or DIGGER \_\_\_\_\_

ADDITIONAL DATA:

Log NA Water Level Measurements \_\_\_\_\_ Chemical Analysis \_\_\_\_\_ Aquifer Test \_\_\_\_\_

REMARKS: